


DATE _____

TOWN OF LEXINGTON — BOARD OF PUBLIC WORKS

WATER DIVISION

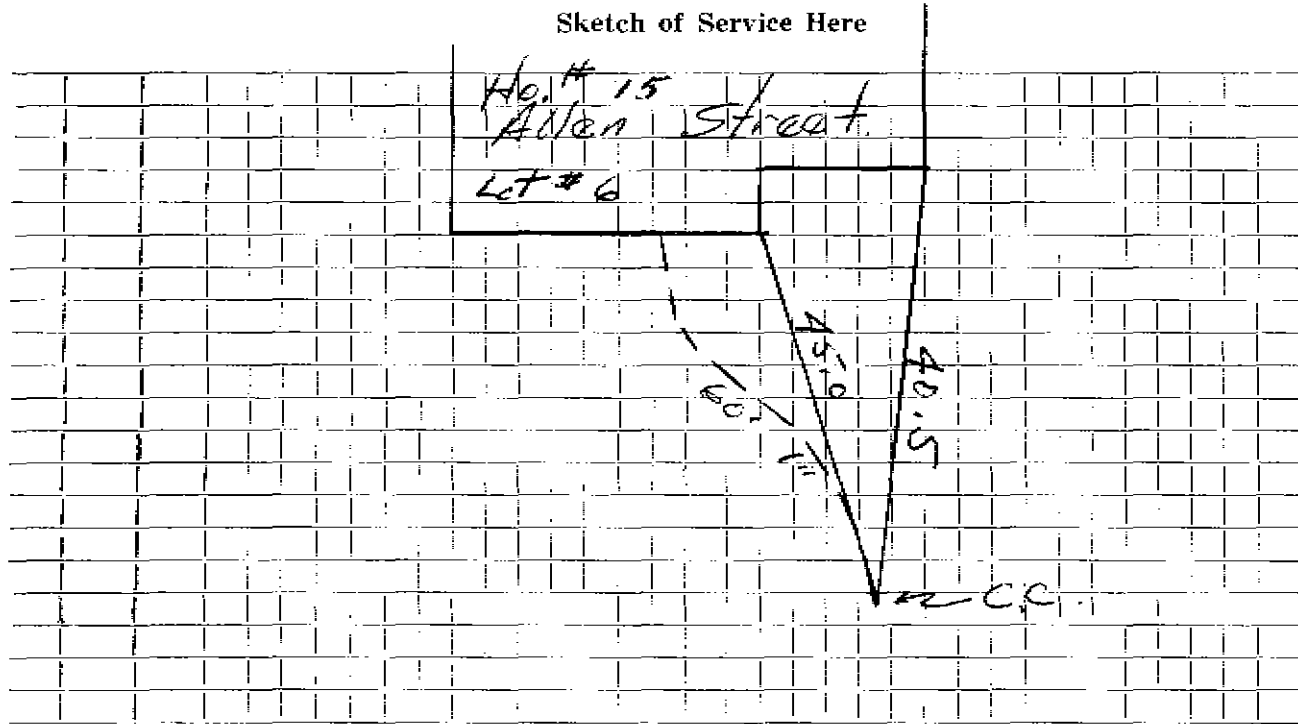

Connection made in Street. Work completed

Remarks:
.
.