

WATER SERVICE RECORD

Name ~~William Sullivan~~ Republic Bldg. Corp.

Service No. 7

Address 19 Allen Street

Location

Repair: ~~Renewal~~ — New Service W.O. #1846. Dave Eagle #2446

FEB 10 1975

Date	Material	Amount	Total	Date	Amount	
3-27-74	Labor	37.29		3-27-74	Deposit	161.00
	10% O.H.	3.73	\$ 41.02	5-10-75	* Retund	8.96
16'	1" Copper Pipe @1.35		21.60			157.04
1	1" Corporation		15.17		Outside (non-Charge)	
1	1" Curb Cock		16.97	4-19-74	Labor	\$37.17
1	Box & Rod		7.34	3	Hrs. Trucking @3.00	9.00
1	Patch 5½' x 10'		33.00	½	Hr. Roller	2.00
1	Hr. Trucking		3.00	½	Hr. Roller Compressor	3.00
2	Hrs. Backhoe @6.50		13.00	½	Hr. Loader	4.00
			\$151.10	½	Ton Cold Patch	2.06
						\$ 57.23
3/29/74	69' 1" Copper					


* Applied to W.O. #6

DATE _____

TOWN OF LEXINGTON — BOARD OF PUBLIC WORKS

WATER DIVISION

Sketch of Service Here

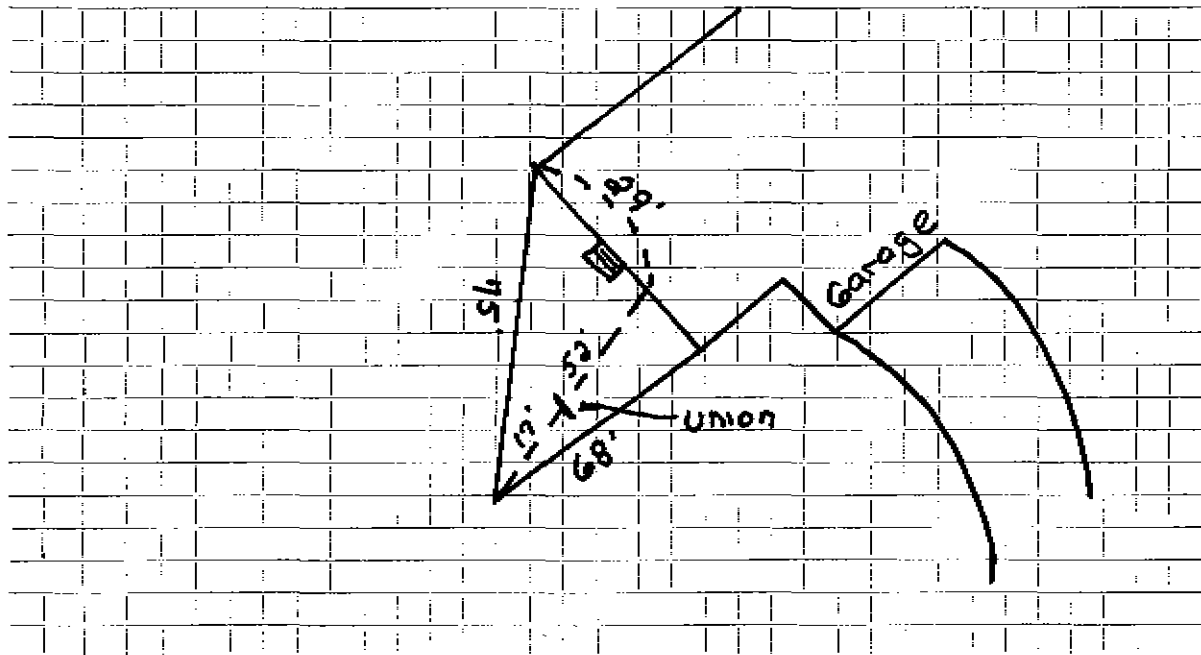

Connection made in Street. Work completed

Remarks:

.....

.....