




DATE \_\_\_\_\_

TOWN OF LEXINGTON — BOARD OF PUBLIC WORKS  
**WATER DIVISION**

Sketch of Service Here

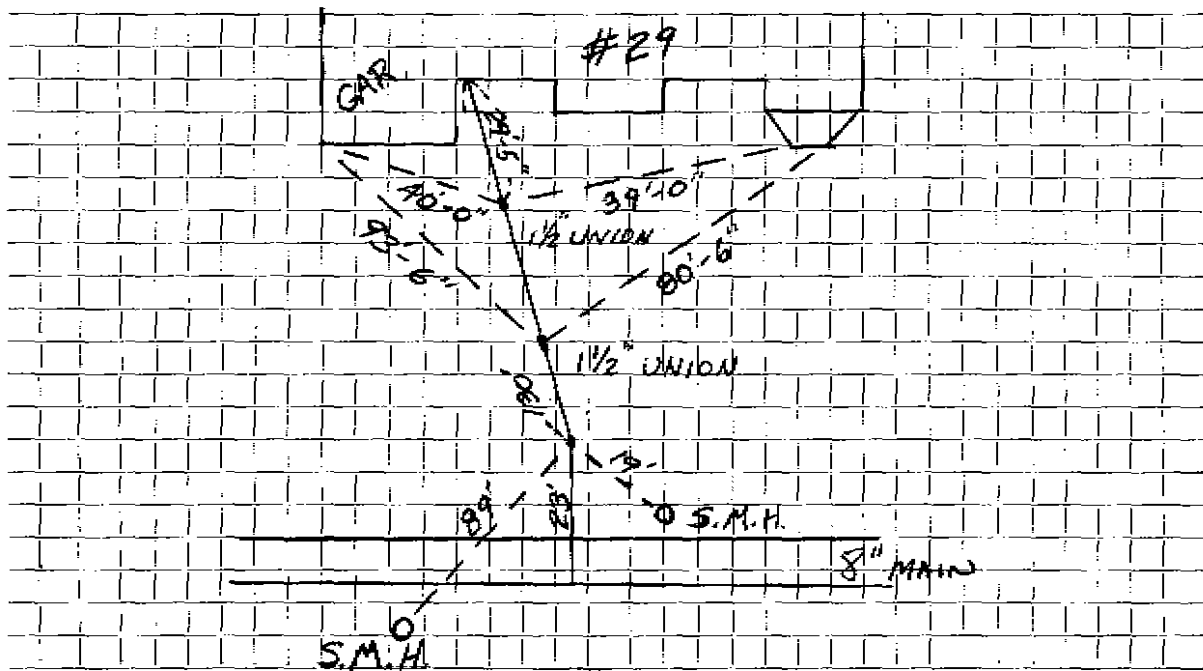

Connection made in ALLEN ST. Street. Work completed .....

Remarks: NO OUTSIDE TIES .....