

## WATER SERVICE RECORD

Service No. #5.

Name Republic Building Corporation

Address 3 Allen Street

Location

~~Renewal~~ New Service W.O.#1844.


FEB 10 1975

Date	Material	Amount	Total	Date	Amount	
-74	Labor	\$24.76		3-8-74	Deposit	240
74	Labor	27.26	\$52.02			
	10% O.H.	5.20	\$57.22			
25'	1" Water Pipe @1.35		33.75		Outside (NON-CHARGE)	
1	1" Corporation		15.17	4-19-74	Labor	\$37.17
1	1" Curb Cock		16.97	3	Hrs. Trucking @3.00	9.00
1	Box & Rod		7.34	1	Hr. Pick up	1.50
2	Hrs. Trucking @3.00		6.00	1	Hr. Roller	2.00
2	Hrs. Backhoe @6.50		13.00	1	Hr. Compressor	5.00
1	Patch		106.80	1	Hr. Loader	4.00
			\$256.25			\$62.89

DATE \_\_\_\_\_

TOWN OF LEXINGTON — BOARD OF PUBLIC WORKS  
**WATER DIVISION**

Sketch of Service Here

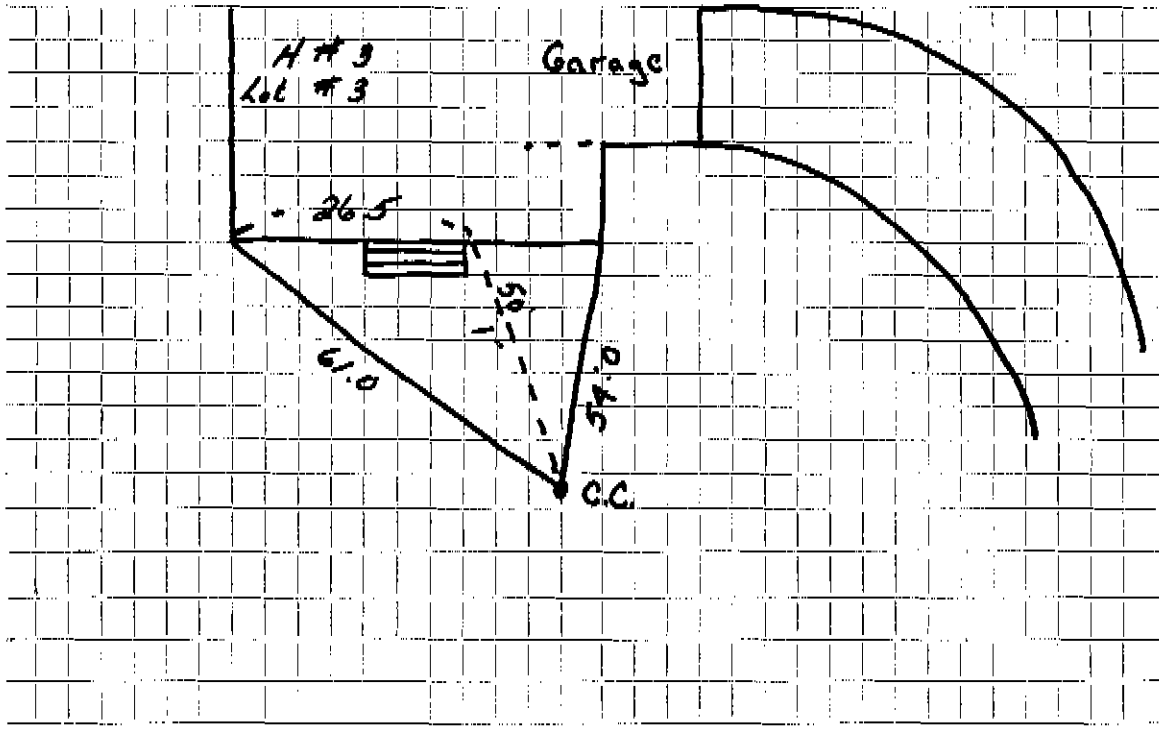

Connection made in ..... Street. Work completed .....

Remarks: .....

.....


.....

DATE \_\_\_\_\_

TOWN OF LEXINGTON — BOARD OF PUBLIC WORKS

**WATER DIVISION**

Sketch of Service Here

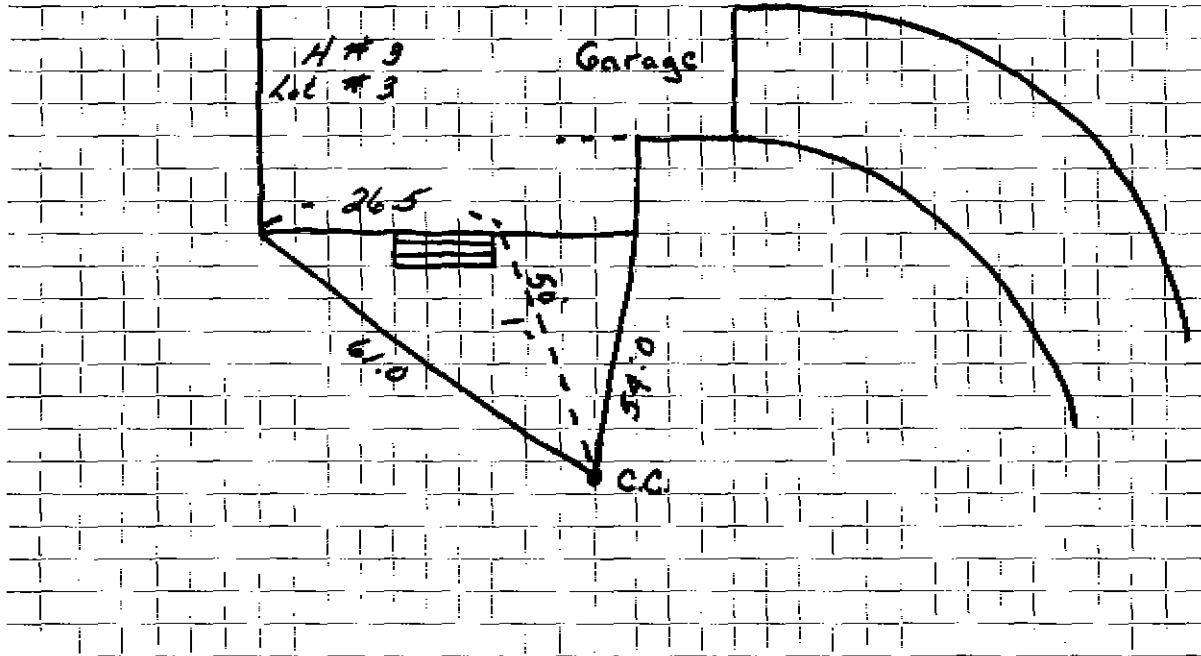

Connection made in ..... Street. Work completed .....

Remarks: .....

.....

.....