

WATER SERVICE RECORD

Name *Carroll's Barn*

Service No.

Address *31 B Allen Street*

Location *PIT*

Repair—Renewal—New Service


Date	Material	Amount	Total	Date		Amount
<i>5/9/83</i>	<i>4' 3/4" Copper Frame &amp; Cover 1" Standpipe</i>					
					<i>OUTSIDE</i>	
				<i>5/9/83</i>	<i>14' 1" Copper Tubing 1" Corp. 1" Curb Box &amp; Rod</i>	

DATE \_\_\_\_\_

# TOWN OF LEXINGTON — BOARD OF PUBLIC WORKS

## WATER DIVISION

Sketch of Service Here

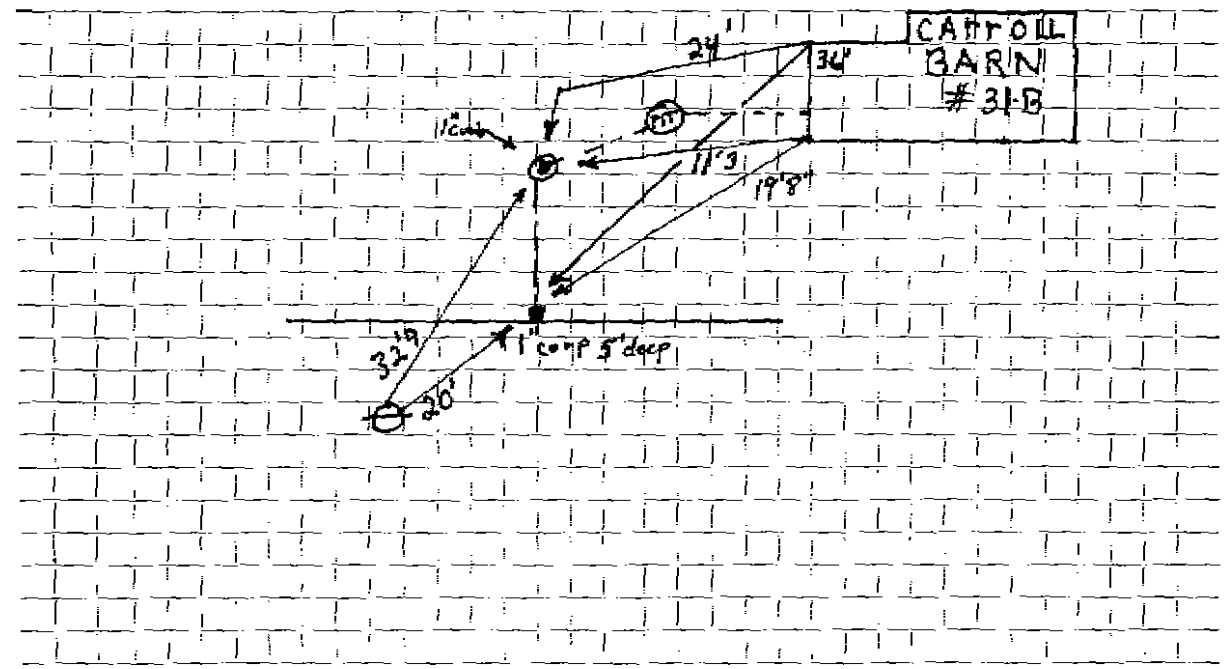

Connection made in ..... Street. Work completed .....

Remarks: *1" COPPER OUT - 3/4 COPPER INSIDE* .....

.....  
.....