

WATER SERVICE RECORD

Name Robert Carroll

Service No. 152

Address 41 Allen Street # 2557

Location W.O. #9411

~~Repair, Renewal~~ New Service DeFlice Bros. Permit #203

MAY 17 1965

Date	Material	Amount	Total	Date	Amount
12-31-64	CURB TO MAIN Labor	56.52		12-29-64	70.00
	10% O.H.	5.65	62.17	8-10-65	44.89
17'	3/4" Copper tubing @.42		7.14		114.86
1	3/4" C Corp Cock		7.41		
1	3/4" C Curb Cock		8.76		
1	Box & Rod		4.90		
15	x 3 Patch		15.00		
1	hr. Town Shovel		6.50		
1	hr. Town Truck		3.00		
			114.88		
2-17-65	114' 3/4" Copper tubing				


Bill DeFlice

DATE _____

TOWN OF LEXINGTON — BOARD OF PUBLIC WORKS

WATER DIVISION

Sketch of Service Here

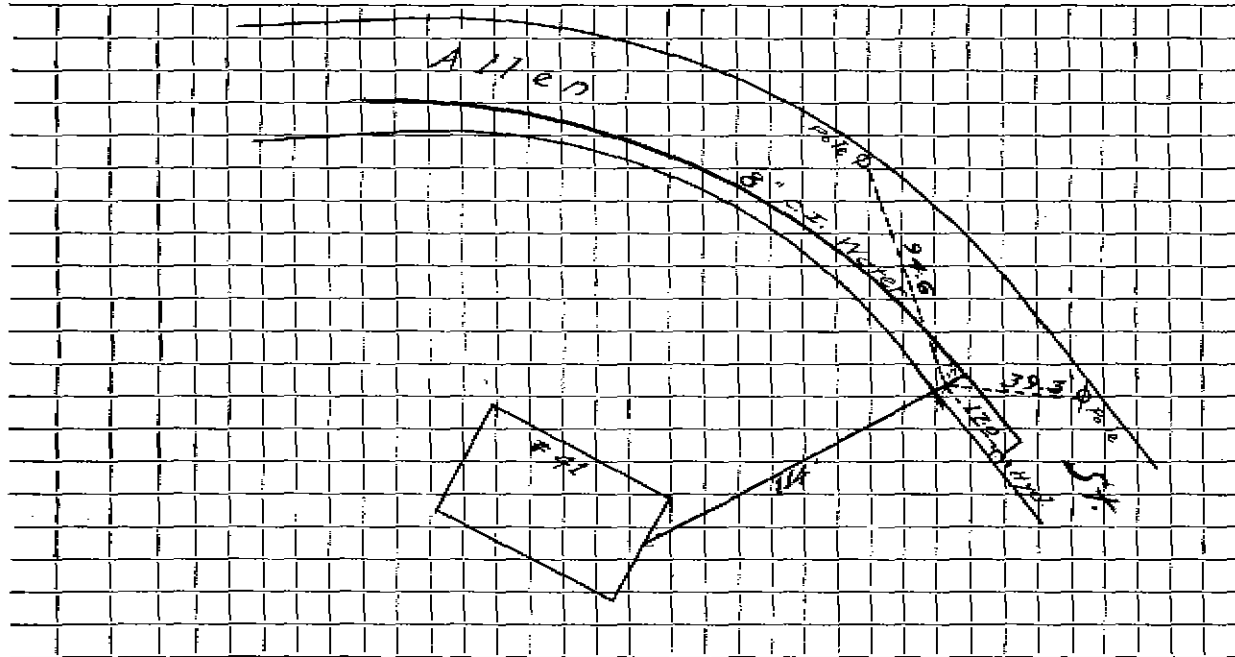

Connection made in Street. Work completed

Remarks:

.....

.....