



WATER SERVICE RECORD

Name Wesley Nelson

Service No. 88

Address #48 Allen Street

Location

Repair - ~~Renewal~~ - New Service Deflice Brothers W.O.#.3654

SEP 5 1967


Date	Material	Amount	Total	Date	Amount
11/23/66	Labor	40.08		11-14-66	Deposit
12/16/66	"	34.52	74.60	7-26-67	Paid
	10% O.H.	7.46	82.06		
14'	3/4" Copper Pipe @.79		11.06		
1	Box and Rod		5.10		
1	3/4" Curb Cock		8.76		
1	3/4" Corp.		7.42		
700	Lbs. Cold Patch @5.00 Ton		1.75		
2	Ton Hot Top @5.50		11.00		
1/2	Hr. Roller @3.00		1.50		
1	Hr. Trucking @3.00		3.00		
1/2	Hr. Backhoe		3.25		
1/2	Hr. Compressor		2.50		
1	Hr. Trucking @3.00		3.00		
			140.40		
11-30-66	58' 3/4" Copper tubing				

DATE \_\_\_\_\_

# TOWN OF LEXINGTON — BOARD OF PUBLIC WORKS

## WATER DIVISION

Sketch of Service Here

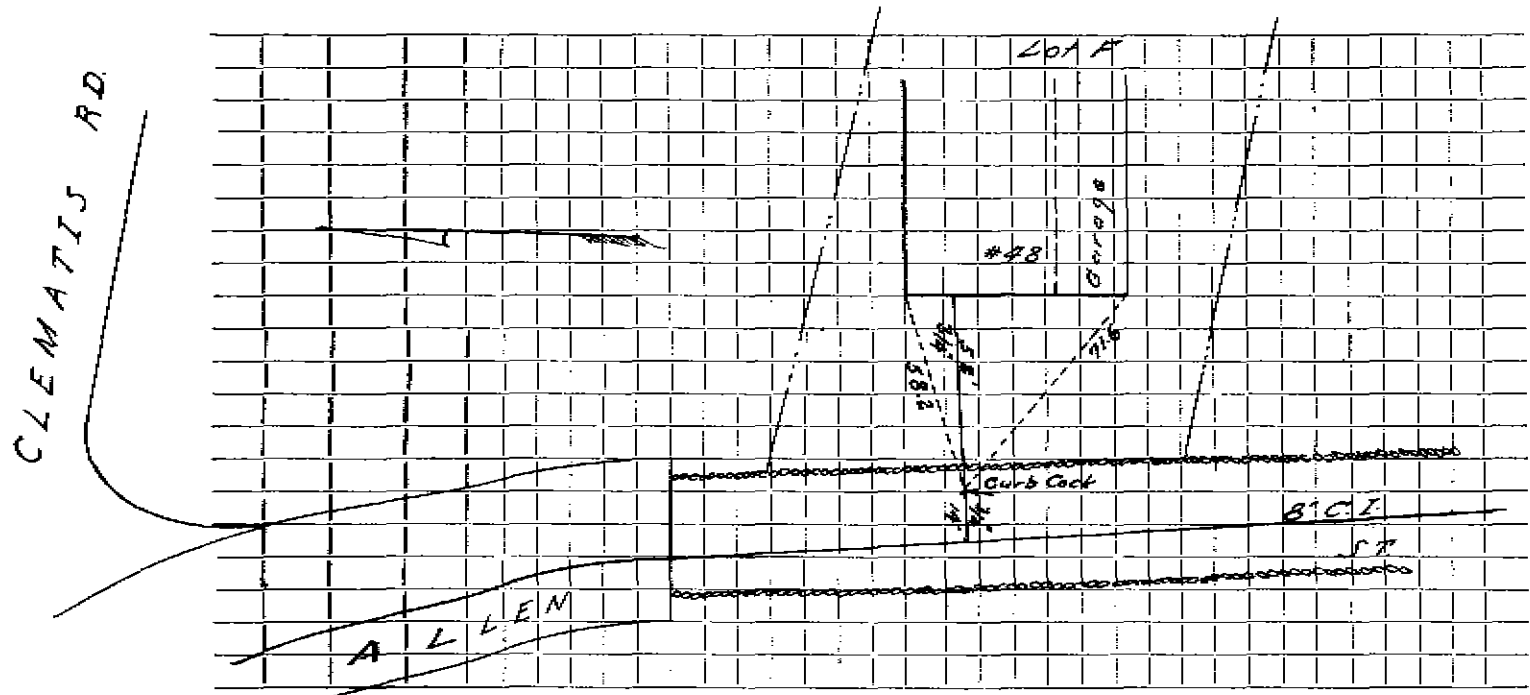

Connection made in \_\_\_\_\_ Street. Work completed \_\_\_\_\_

Remarks: \_\_\_\_\_  
\_\_\_\_\_  
\_\_\_\_\_