

WATER SERVICE RECORD

Name Wesley Nelson

Service No. 55

Address ~~53 Allen Street~~ (stamped ~~to~~) ~~77~~ 50 Allen St. 4/30/70

Location

Repair—Renewal—New Service W.O.#.5377 Suburbante # 934

MAR 18 1968

Date	Material	Amount	Total	Date	Amount
8/11/67	Labor	46.12		8-28-67	Deposit
	"	12.92	59 04		
	10% O.H.	5 90	64 94		
18'	3/4" copper pipe @.79		14 22		
1	3/4" curb cock		8 76		
1	3/4" corp.		7 42		
1	ton cold patch		1 25		
	Box & Rod		5 10		
1	ton hot top		5 80		
3 1/2	hrs. trucking @3.00		10 50		
3	hrs. shovel @6.50		19 50		
1	hr. compressor @5.00		5 00		
1/2	hr. roller @3.00		1 50		
			143 99		
10-31-67 54'	3/4" Copper tubing				


Bill sent 12 29

DATE _____

TOWN OF LEXINGTON — BOARD OF PUBLIC WORKS

WATER DIVISION

Sketch of Service Here

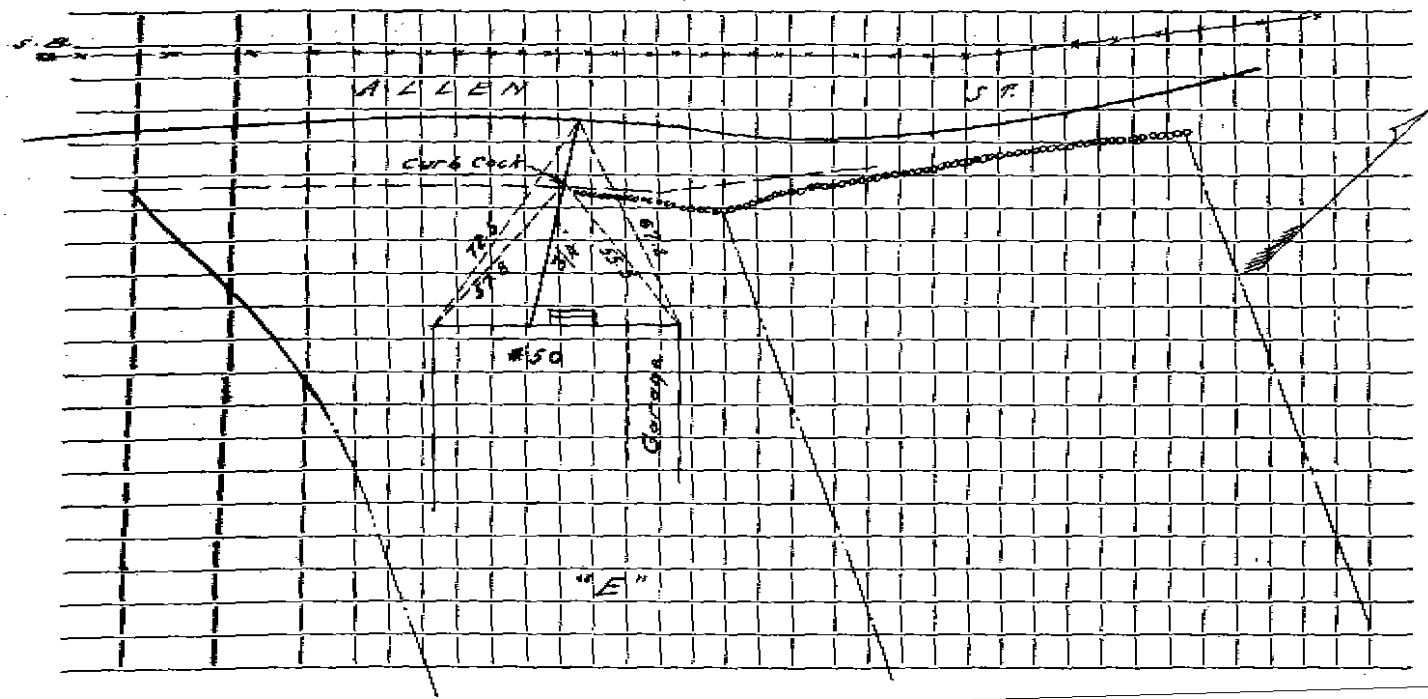

Connection made in _____ Street. Work completed _____

Remarks: _____

