

WATER SERVICE RECORD

Name Carrie Frost

Service No. 48

Address 56 Allen Street

Location

Repair ~~Renewal~~ New Service W.O. # 9081


NOV 23 1970

Date	Material	Amount	Total	Date	Amount
10/15/70	Labor	41 54		10/13/70	175 00
10/27/70	"	18 39		11/23/70	14 31
10/27/70	"	13 42	73 35		140 69
10%	O.H.		7 34		
19'	3/4" Copper pipe .79		15 01		
	3/4" Corporation		9 57		
	3/4" Curb stop		11 32		
	Box & Rod		5 10		
1/2	Ton Cold patch 6.00		3 00		
1	Hot top		6 00		
2 1/2	Hrs. Trucking 3.00		7 50		
1	" "		1 50		
2	" Shovel 6.50		13 00		
1	" Compressor		5 00		
1/2	" Roller 2.00		1 00		
	Trailer		2 00		
			160 69		

DATE _____

TOWN OF LEXINGTON - BOARD OF PUBLIC WORKS
WATER DIVISION

Sketch of Service Here

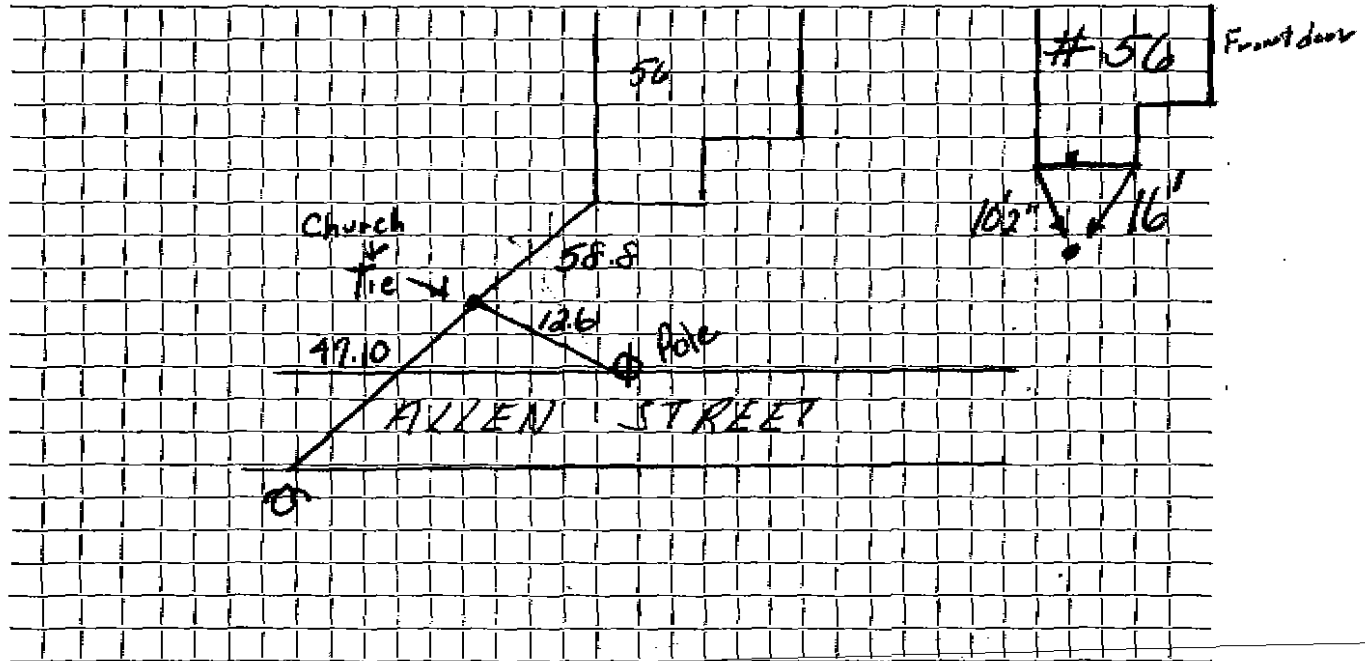

Connection made in Street. Work completed

Remarks:

.....

.....