

WATER SERVICE RECORD

Name Paul Paone

Service No. 47

Address 58 Allen Street

Location

Repair—Renewal—New Service Gatley #720 ~~Max 5507~~


MAR 18 1968

Date	Material	Amount	Total	Date	Amount
8-10-67	110' 1" Copper tubing			7-28-67	100 00
				3-27-68	34 41
7/28/67	Labor	43.91			134 41
	"	3.95			
	"	6.10	53 96		
	10% O.H.		5 40		
	16' 1" copperpipe @.99		15 84		
	1 1" corp.		10 66		
	1 1" curb cock		11 15		
	box & rod		5 10		
	1 ton hot top		5 80		
	2 1/2 hrs. trucking @3.00		7 50		
	2 hrs. shovel @ 6.50		13 00		
	1/2 hr. compressor @ 5.00		2 50		
	1/2 hr. loader @ 4.00		2 00		
	1/2 hr. roller @ 3.00		1 50		
			134 41		

DATE \_\_\_\_\_

# TOWN OF LEXINGTON — BOARD OF PUBLIC WORKS

## WATER DIVISION

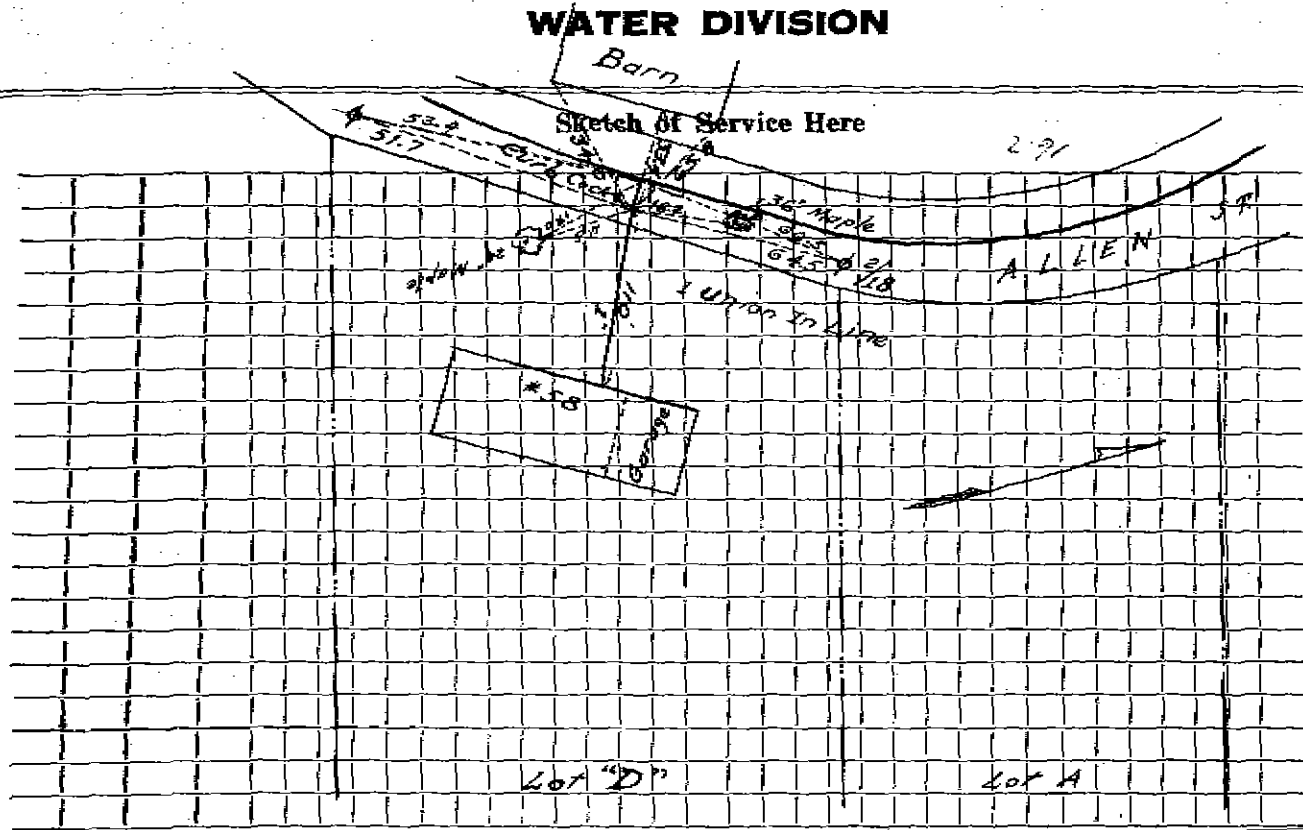

Connection made in ..... Street. Work completed .....

Remarks: .....  
.....  
.....