

WATER SERVICE RECORD

Name William F. Sullivan

Service No. 101

Address 3 Allen Street

Location

Repair ~~Renewal~~ New Service

Comm 8-1-60

Date	Material	Amount	Total	Date	Amount
6-23-60	Labor	38 10		6-23-60	Deposit 100 00
	10% O.H.	3 81	41 91	8-8-60	Paid 4 14
72	3/4" Copper tubing 342		33 18		100 14
1	3/4" 3x1/2 I.P.F. Stop & Waste		6 14		
1	3/4" CS part union		2 41		<u>NON CHARGE</u>
3	Hrs pipping shovel 84.50		13 50	10	3/4" Copper tubing 342 4 20
1	Hr Trucking 33.00		3 00	1	3/4" C Corp Cock 4 91
	6x3 Patch		5 00	1	3/4" C Curb Cock 6 28
			105 14	1	Box & Rod 5 00
				1 1/8	Offset tailpiece 50
				1 1/8	Straight tailpiece 50
					Labor 4 83
					26 22
8/2/60	Labor	1 44			
	10% O. H.	79			
1	Box & Rod	4 50			
1	Hr. Trucking	300			
		10 03			


Comm. 9-6-60

DATE _____

TOWN OF LEXINGTON — BOARD OF PUBLIC WORKS

WATER DIVISION

Sketch of Service Here

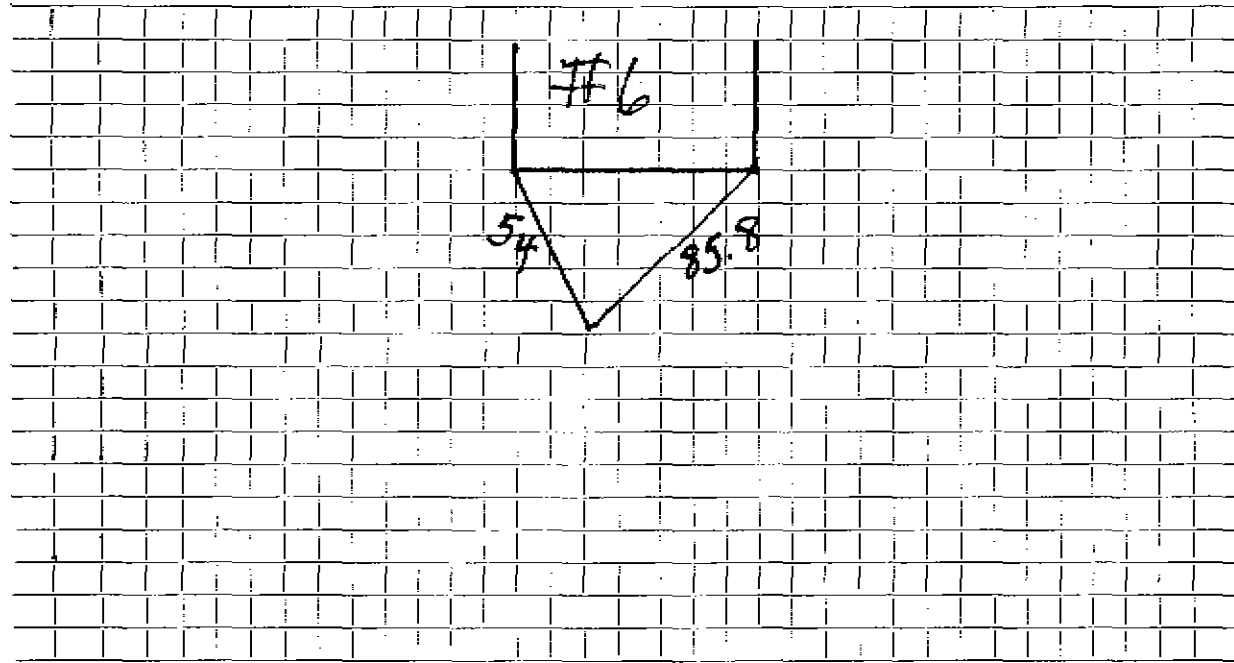

Connection made in Street. Work completed

Remarks:
.....
.....