


Date: 6/21/22

TOWN OF LEXINGTON - BOARD OF PUBLIC WORKS
WATER DIVISION

SKETCH OF SERVICE HERE

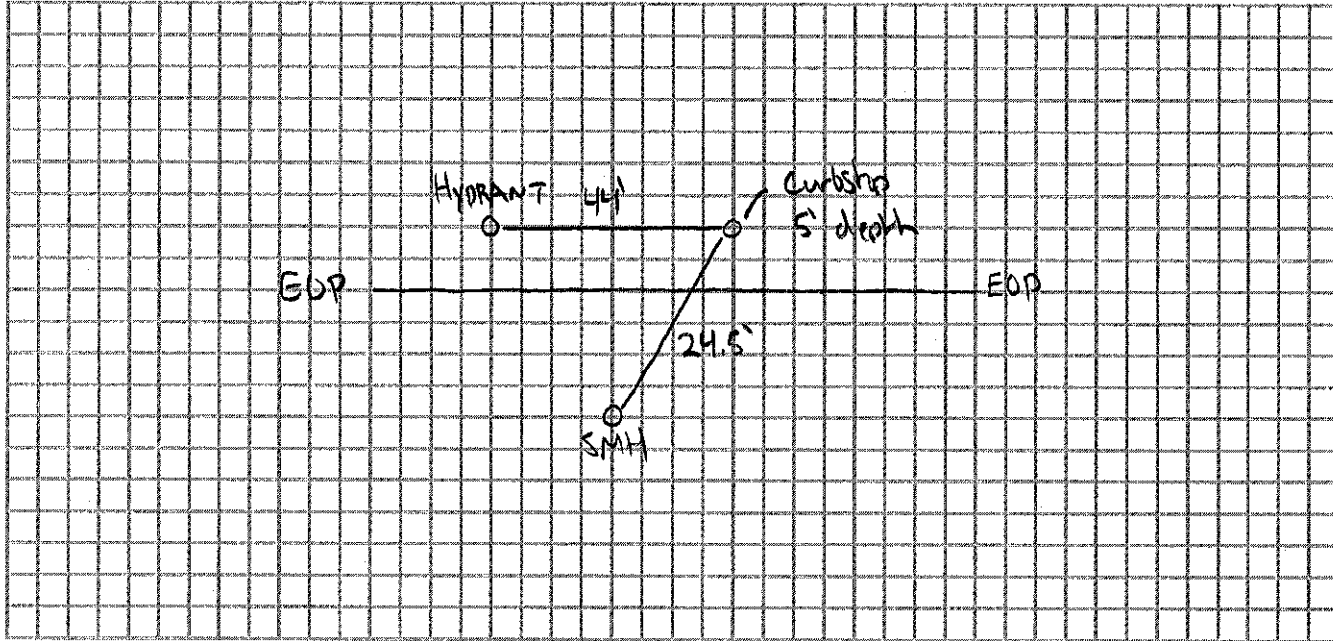

Connection made in: ALLEN ST Street. Work completed:

Remarks: INSTALLED BY MCLAUGHLIN

MEASURED FROM TOP OF HYDRANT

MEASURED FROM CENTER OF MANHOLE COVER