

WATER SERVICE RECORD

Name **Richard A. Johnson**Service No. **39**Address **66Allen**

Location


~~Repair~~ ~~Reservoir~~ ~~New Service~~ **Outside - W.O. # 8966 Dave Eagle #1723****NOV 23 1970**

Date	Material	Amount	Total	Date	Amount
9/21/70	Labor	45 52		9-9-70	Deposit 300 00
9/29/70	"	32 11	77 63	11-23-70	* Refund 26 71
	10% O.H.		7 76		173 29
29'	3/4" Copper pipe .79		22 91		
1	3/4" Corporation		9 57		
1	3/4" Curb Cock		11 32		
1	Box & Rod		5 10		
1	Ton hot top		6 00		
1/2	Ton cold patch 6.00		1 50		
3 1/2	Hrs. trucking 3.00		10 50		
2	Hrs. Shovel 6.50		13 00		
1	" Compressor		5 00		
1/2	" Roller 2.00		1 00		
	Trailer		2 00		
			173 29		
9/25/70	72' 3/4" Copper tubing				
					* Apply 11.87 to W.O. # 40

DATE _____

TOWN OF LEXINGTON -- BOARD OF PUBLIC WORKS WATER DIVISION

Sketch of Service Here

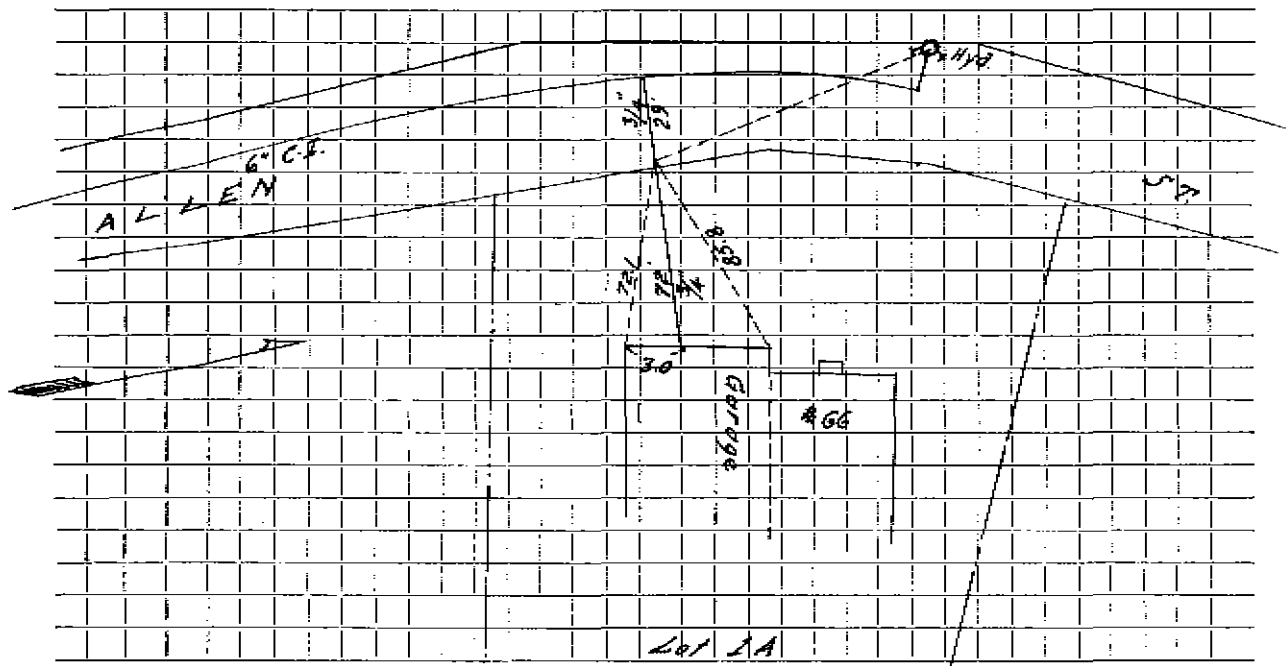

Connection made in Street. Work completed

Remarks:
.....
.....