

WATER SERVICE RECORD

3116
124

Name Martin Hopkins

Service No.

Address 69 Allen St.

Location Lexington

Repair ~~xxxxxx~~ - New Service

Am. 7-13-53


Date	Material	Amount	Total	Date	Amount
6/11/53	Labor	4 87		6-5-53 Deposited	65 00
	10% overhead	49	5 36	7-13-53 Refunded	(9 41)
	54'-3/4" Copper Tubing @.37		19 98		NON CHARGE
	1-3/4" C x 3/4" I.W.H. STOP & WASTE		4 00	6/11/53 Labor	4 88
	3 Hr. Littlefield shovel @7.50		22 50	14'-3/4" Copper Tubing @.37	5 18
	1 Hr. Trucking		75	1-3/4" C. Corp-cock	4 33
	Patching 3 x 3		3 00	1-3/4" C x 3/4" C. Curb-cock	4 67
			55 59	1-Box & Rod	3 90
				1-3/4 offset tail piece	50
				1-1/2 straight tail piece	50
				1 Hr. Littlefield shovel	7 50
				1 hr. trucking	75
					32 21

DATE _____

TOWN OF LEXINGTON — BOARD OF PUBLIC WORKS

WATER DIVISION

Sketch of Service Here

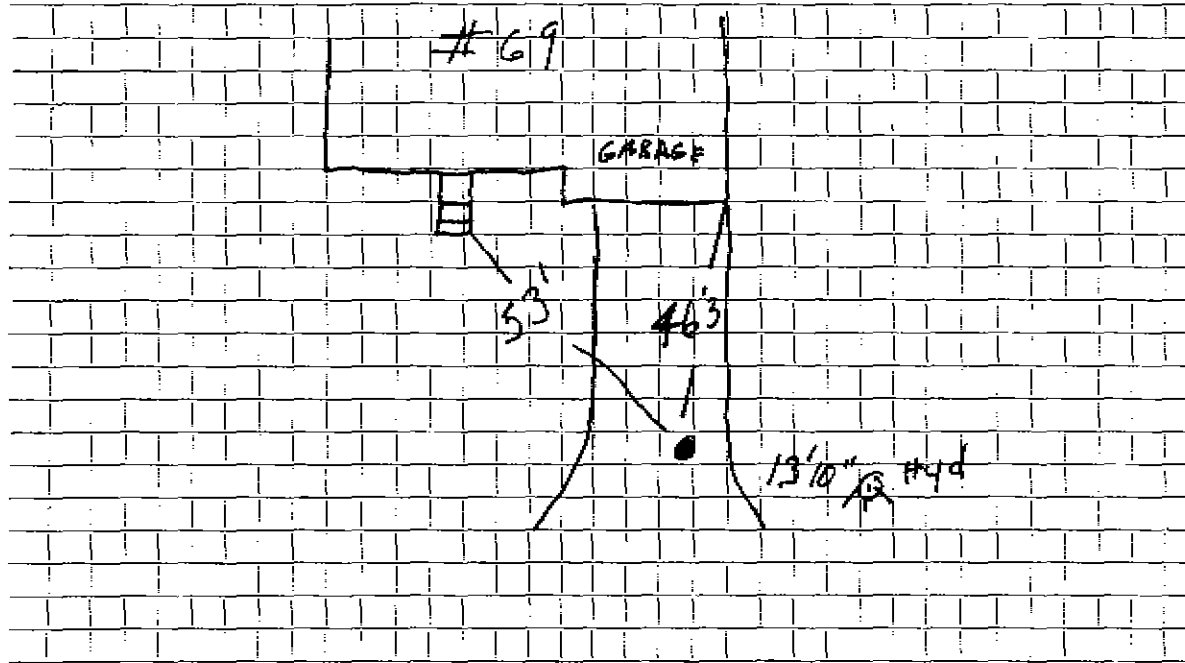

Connection made in Street. Work completed

Remarks:

.....

.....