

WATER SERVICE RECORD

Name William Sullivan Republic Bldg CorpService No. 6Address 7 Allen Street

Location

~~Repair, Renewal~~ New Service W.O. #1845. Dave Eagle #2460


FEB 10 1975

Date	Material	Amount	Total	Date	Amount
3-8-74	Labor	37.29		3-8-74	540.00
	10% O.H.	3.73	\$41.02	3-16-75	8.90
25'	1" Copper Pipe @1.35		33.75	2-13-88	23.25
1	1" Corporation		15.17		NON-CHARGE (outside)
1	1" Curb Cock		16.97	4-19-74	\$37.17
1	Box & Rod		7.34	3	Hrs. Trucking @3.00
1	Patch 23' x 8'		122.40	1	Hr. Pick up
1	Hr. Trucking		3.00	1	Hr. Roller
2	Hrs. Backhoe @6.50		13.00	1	Hr. Compressor
			\$252.65	1	Hr. Loader
3/29/74	88' 1" Copper				4.00
					\$60.67

DATE _____

TOWN OF LEXINGTON — BOARD OF PUBLIC WORKS
WATER DIVISION

Sketch of Service Here

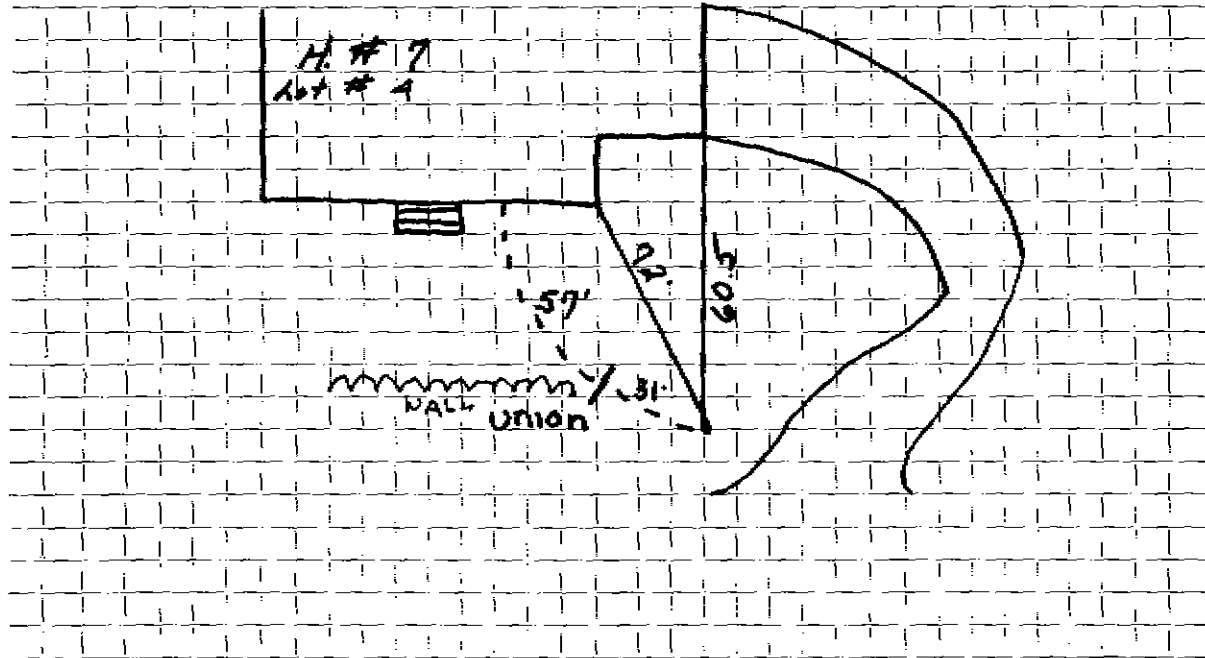

Connection made in Street. Work completed

Remarks: CURB BETWEEN END OF WALL ORWAY