

WATER SERVICE RECORD

Name Philip Spencer

Service No. 153

Address 75 Allen Street

Location

~~XXXXXXXXXX~~ New Service

Comm 8-22-60


Date	Material	Amount	Total	Date	Amount
7-29-60	Labor	25 30		7-28-60	Deposit 100 00
	10% O.H.	<u>2 53</u>	27 83	8-22-60	Refund 48 41
27'	3/4" Copper tubing @42		11 34		51 59
1	3/4" Cx 1/2 T.W.H. Stop&Waste		6 17		
1/2	Hr Town Shovel @6.50		3 25		NON CHARGE
1	Hr Trucking @3.00		<u>3 00</u>		Labor 10 31
			51 59	11'	3/4" Copper tubing@42 4 62
				1	3/4" C Corp Cock 4 91
				1	3/4" C Curb Cock 6 28
				1	Box & Rod 4 90
				1	1/2 Straight tailpiece 50
				1	1/2 Offset tailpiece 50
					<u>32 02</u>

DATE \_\_\_\_\_

TOWN OF LEXINGTON — BOARD OF PUBLIC WORKS

WATER DIVISION

Sketch of Service Here

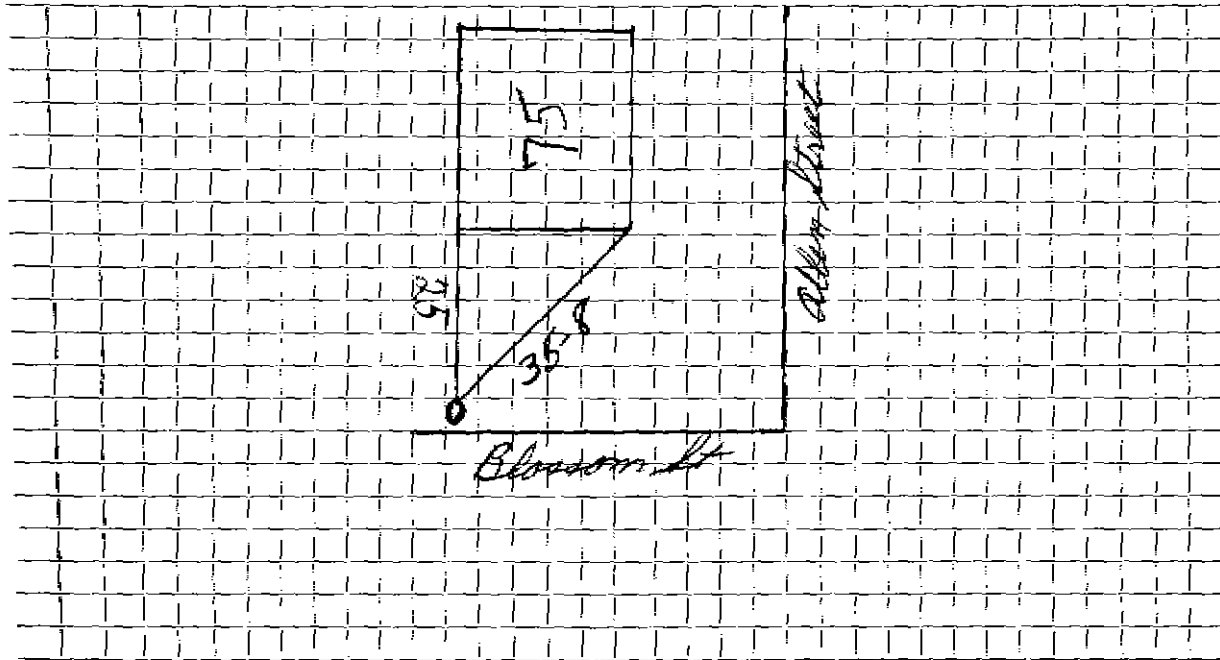

Connection made in ..... Street. Work completed .....

Remarks: .....  
.....  
.....