

WATER SERVICE RECORD

#5147

Name William Sullivan

Service No. 155

Address 8 Allen Street

Location

~~Repair-Renewal~~ New Service

Comm 9-19-60


Date	Material	Amount	Total	Date	Amount	
8-5-60	Labor	22.05		7-29-60	Deposit	100.00
	10% O.H.	2.21	24.26	9-19-60	Retained	22.01
70'	3/4" Copper tubing @.42		29.40			77.99
1	3/4" C x 1/2 I.W.H. Stop & Waste		6.17		NON CHARGE	
1	3/4" C 3 part union		2.41	8-5-60	Labor	6.96
1 1/2	hrs. Town Shovel @6.50		9.75	22'	3/4" Copper tubing @.42	9.24
2	hrs. Trucking @3.00		6.00	1	3/4" C Corp Cook	4.91
			77.99	1	3/4" C Curb Cook	6.28
				1	Box & Rod	4.90
				1	1/2 Straight tailpiece	.50
				1	1/2 Offset tailpiece	.50
						33.29

DATE _____

TOWN OF LEXINGTON — BOARD OF PUBLIC WORKS

WATER DIVISION

Sketch of Service Here

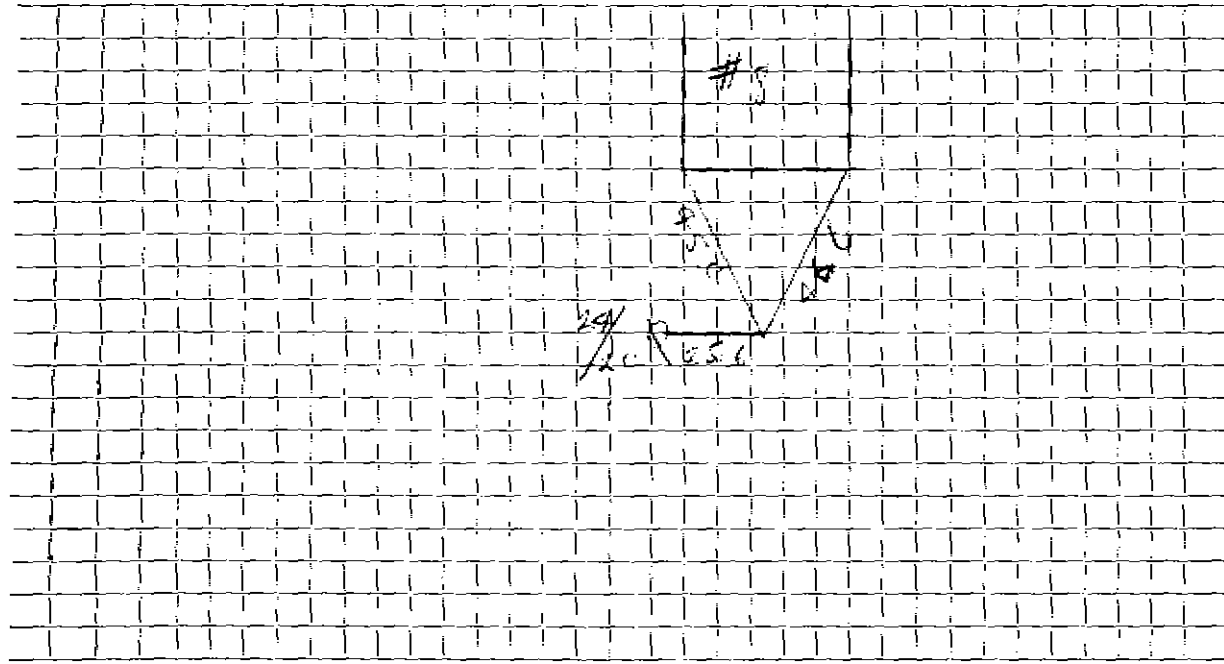

Connection made in Street. Work completed

Remarks:
.....
.....