

WATER SERVICE RECORD

Name

Service No.

Address

Allen Street

Location

Lot T 11

~~REPAIR~~ ~~RENEW~~

New Service


Date	Material	Amount	Total	Date			Amount
					<u>NON CHARGE</u>		
				8-21-59	Labor		10 92
					12' 3/4" Copper tubing @.38	4	56
					1 3/4" C Corp Cock	4	67
					1 3/4" C Curb Cock	6	07
					1 Box & Rod	5	00
					1 Hr. Trucking		75
						31	97

DATE _____

TOWN OF LEXINGTON — BOARD OF PUBLIC WORKS

WATER DIVISION

Sketch of Service Here

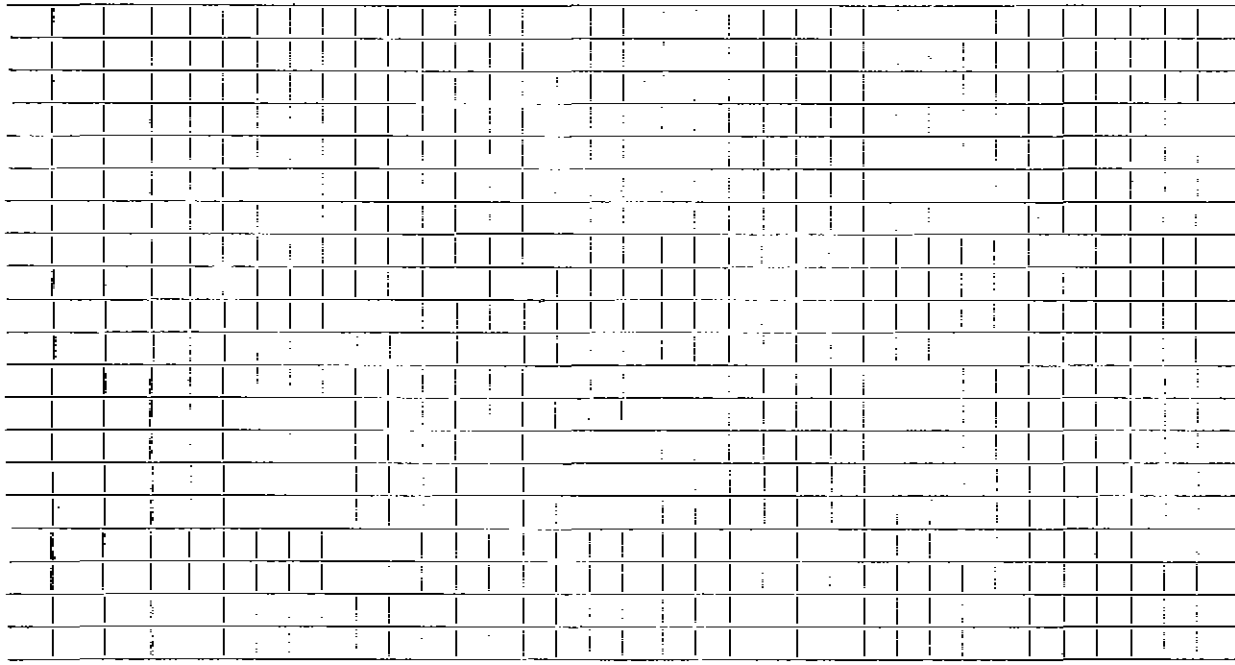

Connection made in Street. Work completed

Remarks:
.....
.....