

WATER SERVICE RECORD

Name L.H. Hewett Jr., Inc.

Service No. 27

Address 3 Alpine Street

Location

~~REPAIR WORK~~ New Service Hewett #3481 W.O.#830

JUL 7 1980

Date	Material	Amount	Total	Date	Amount
12-19-79	Labor	133.40		10-30-79	440.00
	10% C.H.	13.34	146.74		118.85
	50' 3/4" Coppertubing @.94	6.94	147.00		281.15
	1 3/4" Corp.		12.40		
	1 3/4" Curb		17.73		
	1 Box & Rod		17.80		
	2 hrs. Trucking @ 3.00		6.00		
	3 hrs. Town Shovel @ 6.50		19.50		
	Hot Top		13.98		
			281.15		
1-18-80	83' 3/4" Copper tubing				


Apply 75.00 to 549.83

DATE _____

TOWN OF LEXINGTON — BOARD OF PUBLIC WORKS

WATER DIVISION

Sketch of Service Here

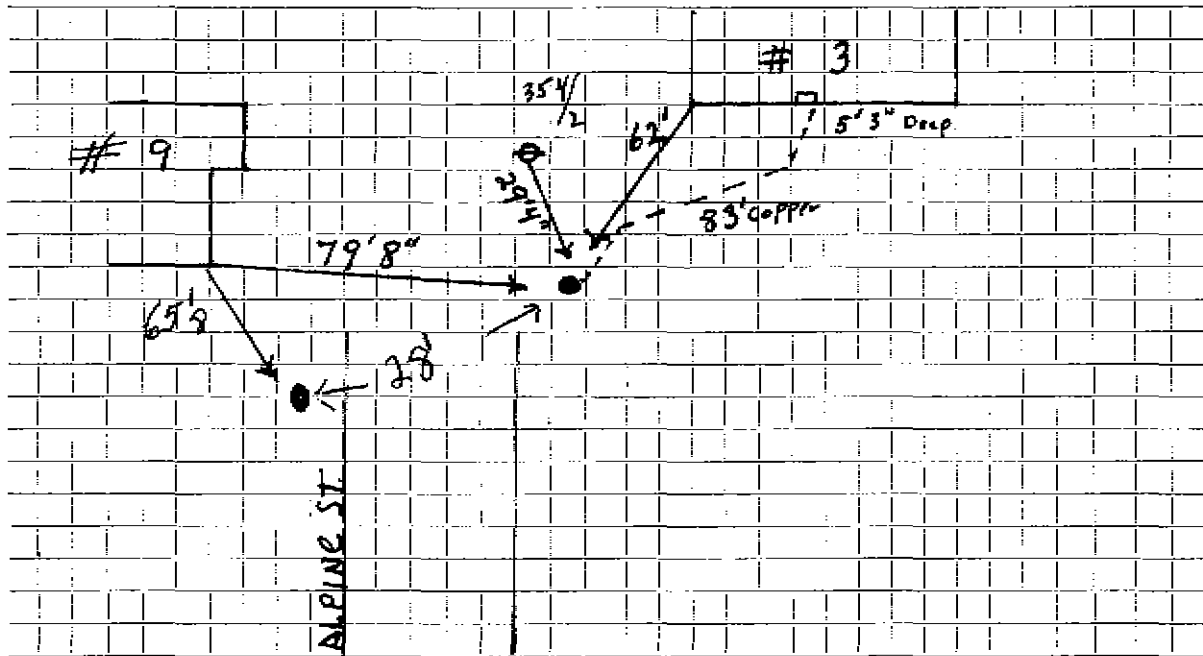

Connection made in Street. Work completed

Remarks:

.....

.....