

WATER SERVICE RECORD

Name Donna Realty

Service No. 94

Address 11 Ames Avenue

Location

~~Replaced~~ New Service Surburbanite Cesspool #A 496

Comm 5-8-67


Date	Material	Amount	Total	Date		Amount
12/10/66	35 * 3/4" Copper			11-30-66	<i>Deposit</i>	31.48
					NON CHARGE	
				8-22-63	Labor	4.47
					26' 3/4" Copper tubing @.42	10.92
					1 3/4" C Curb Cock	6.28
					1 3/4" C Corp Cock	4.91
					1 Box & Rod	4.90
						31.48

DATE \_\_\_\_\_

TOWN OF LEXINGTON — BOARD OF PUBLIC WORKS

WATER DIVISION

Sketch of Service Here

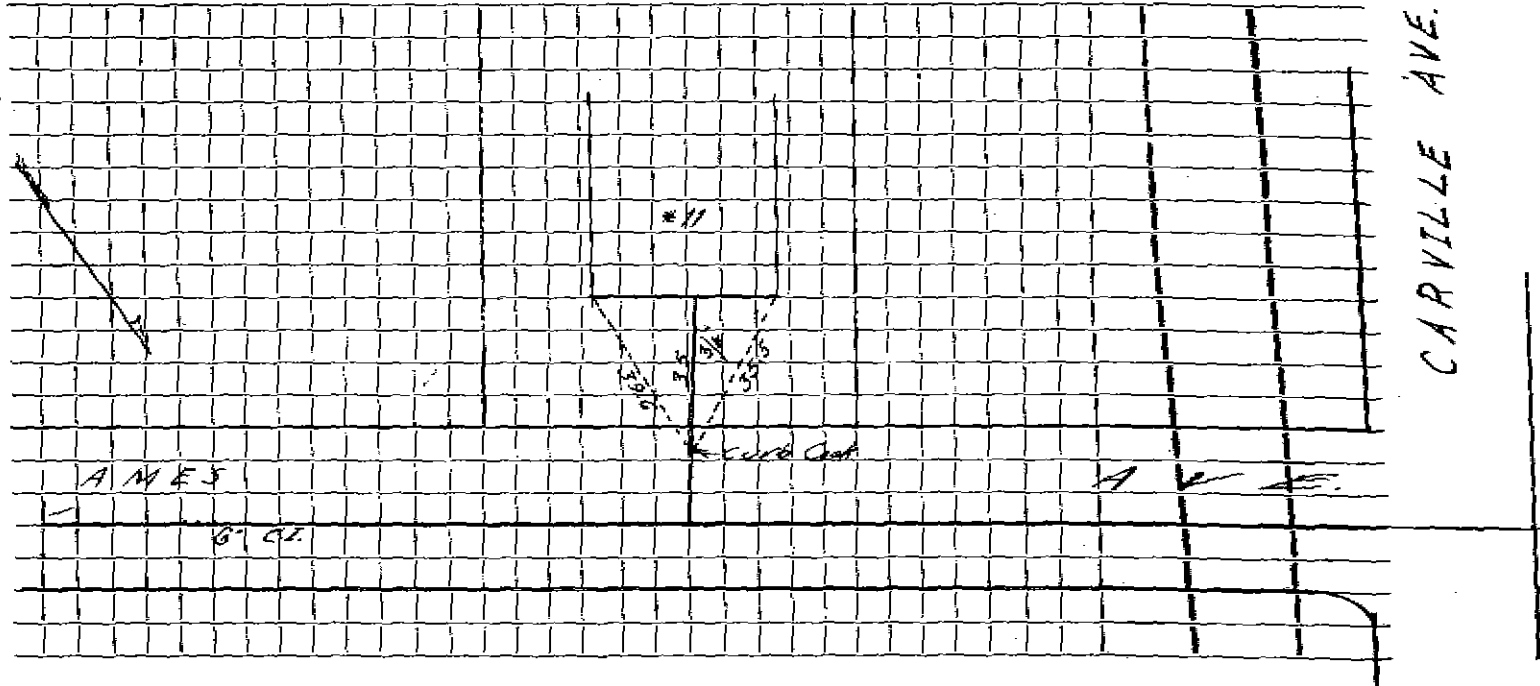

Connection made in ..... Street. Work completed .....

Remarks: .....  
.....  
.....