

WATER SERVICE RECORD

1232

Name Edward F. Tocio

Service No. 51

Address 114 Ames Ave

Location

~~Repair - Remount~~ - New Service

Comm 7-5-60


Date	Material	Amount	Total	Date	Amount
5-5-60	Labor	2.05		4-26-60	Deposit 50 00
	10 % O.H.	.21	2 26	7-5-60	* Retard 20 57
50'	3/4" Copper tubing @ .42		21 00		29 43
1	3/4" Cx 1/2 I.W.H. Stop & Waste		6 17		NON CHARGE
			29 13		Labor 1 61
				10'	3/4" Copper tubing @ .42 4 20
				1	3/4" Curb Cock 6 28
				1	3/4" Corp Cock 4 91
				1	Box & Rod 5 00
				1	1/2 Straight tailpiece 50
				1	1/2 Offset tailpiece 50
					23 00
					* Applied to 5MC # 56

DATE _____

TOWN OF LEXINGTON — BOARD OF PUBLIC WORKS

WATER DIVISION

Sketch of Service Here

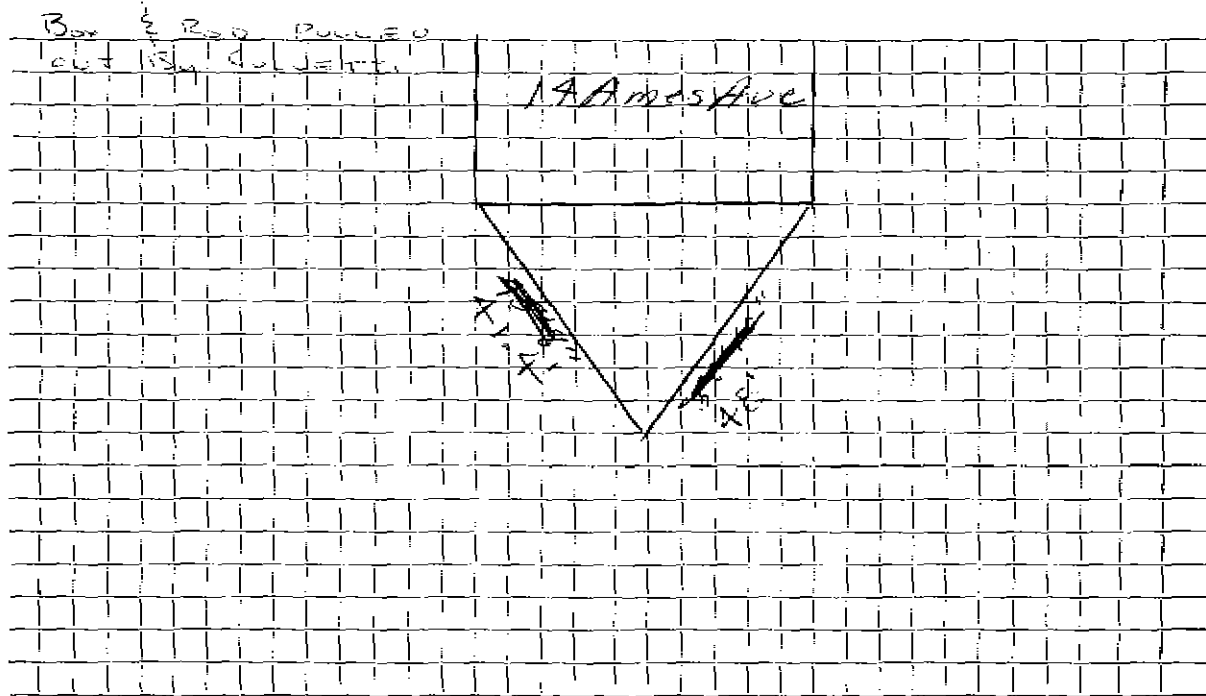

Connection made in Street. Work completed

Remarks:
.....
.....