

Name Emmy H. Anderson

Service No. ~~XXXX~~ 78

Address #26 Ames Ave

Location 26 Ames Ave.

Kind of Pipe

Size

Size of Main

~~Repair~~—Renewal—~~NON CHARGE~~ W.O. #8125

Location Comm 2-10-64

Date	Material	Amount	Total	Date	Amount
8-19-63	Labor		42.34	8-19-63	Deposit 100.00
				2-10-64	Refund 57.66
	NON CHARGE				32.90
39'	3/4" Copper tubing @.42		16.38		NON CHARGE
1	3/4" C x 1/2 I.W.H. Stop & Waste		6.17	8-19-63	Labor 33.58
2	3/4" C x 1" 2 part unions @1.62		3.24	24	3/4" Copper tubing @.42 10.08
1	1" x 3/4" Brass Coupling		.94	1	3/4" C Corp Cock 4.91
1/2	hr. Town Shovel @6.50		3.25	1	3/4" C Curb Cock 6.28
1	hr. Trucking @3.00		<u>3.00</u>	1	Box & Rod 4.90
			32.90	1	1/2 Straight tailpiece .50
				1	1/2 Offset tailpiece .50
				1/2	hr. Town Shovel @6.50 3.25
				1	hr. Trucking @3.00 <u>3.00</u>
	Labor				67.00
					+ 32.90
					99.90

Hadley Press, Inc., Lexington

TOWN OF LEXINGTON—BOARD OF PUBLIC WORKS

WATER DIVISION

The undersigned applies for a supply of water at No. _____ St. and hereby agrees to comply with the rules and regulations as now, or at any future time, established by the Board of Selectmen.

Am't. of Estimate \$ _____

Owner _____

E. Anderson.


Am't. Paid \$ _____

Address _____

~~52~~ Ames Ave. #26

Builder _____

Sketch of Service Here

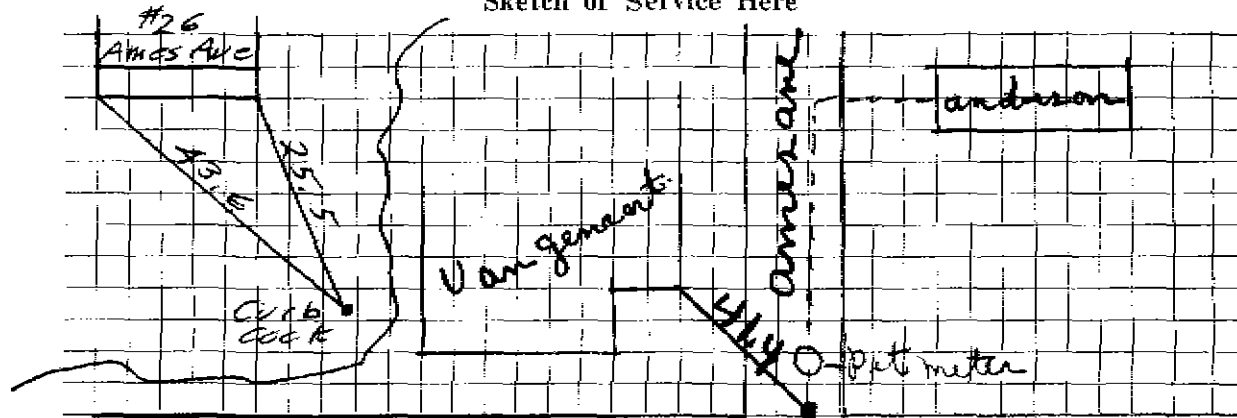

Connection made in Baker Ave Street.

Work completed _____ 19__

Remarks:

35.9
Hyd