

WATER SERVICE RECORD

Service No. 46

Name Ernest A. Grant

Address 32 Ames Avenue

Location

~~Repair - Renewal - New Service~~

Comm: 7/22/57


Date	Material	Amount	Total	Date	Amount
4/16/57	Labor	3 90		3-26-57	50 00
	10% overhead	39	4 29	7-22-57	23 09
	40' - 3/4" Copper tubing @ .4228	16 91			# 26 91
	1 - 3/4" Cx 1/2 I.W.H. Stop & Waste	4 96			NON CHARGE
	1 hr. trucking @ .75		75		Labor
			26 91		3 90
					20' - 3/4" Copper tubing @ .4228
					8 46
					1 - 3/4" C. Corp Cock
					4 64
					1 - 3/4" C. Curb Cock
					5 94
					1 Box & Rod
					4 62
					1 - 1/2 Straight tailpiece
					50
					1 - 1/2 Offset tailpiece
					50
					1/2 hrs. Town Shovel @ 6.50
					3 25
					31 81

DATE _____

TOWN OF LEXINGTON — BOARD OF PUBLIC WORKS

WATER DIVISION

Sketch of Service Here

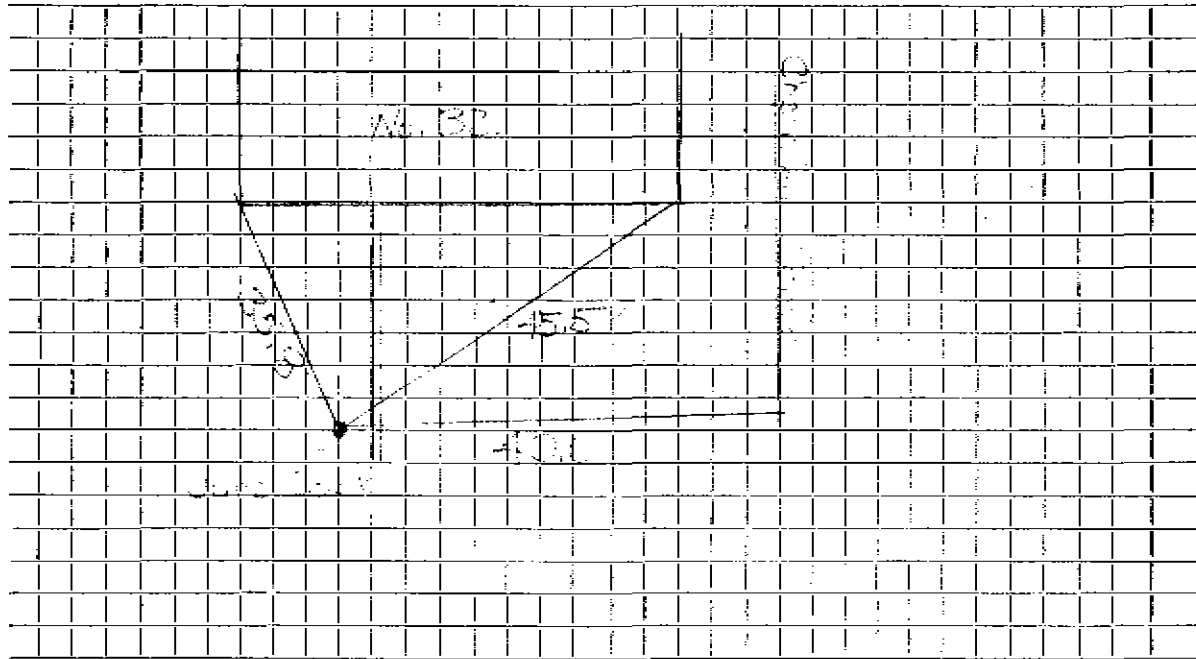

Connection made in Street. Work completed

Remarks:
.....
.....