

## WATER SERVICE RECORD

Name Bernard Maloney

Service No. 16

Address 33 Ames Avenue

#33 Ames Ave

Location Lot 494-495 Sta 4+76.3 Right

Repair—Renewal—New Service Valeri #1018

Aug 5 1968


Date	Material	Amount	Total	Date	Amount
5-13-68	44' 3/4" Copper tubing			5-7-68	Deposit 26.64
					CURB TO MAIN
				8-21-63	Labor 4.25
				15'	3/4" Copper tubing @.42 6.30
				1	3/4" C Corp Cock 4.91
				1	3/4" C Curb Cock 6.28
				1	Box & Rod 4.90
					<u>26.64</u>

DATE \_\_\_\_\_

TOWN OF LEXINGTON — BOARD OF PUBLIC WORKS

WATER DIVISION

Sketch of Service Here

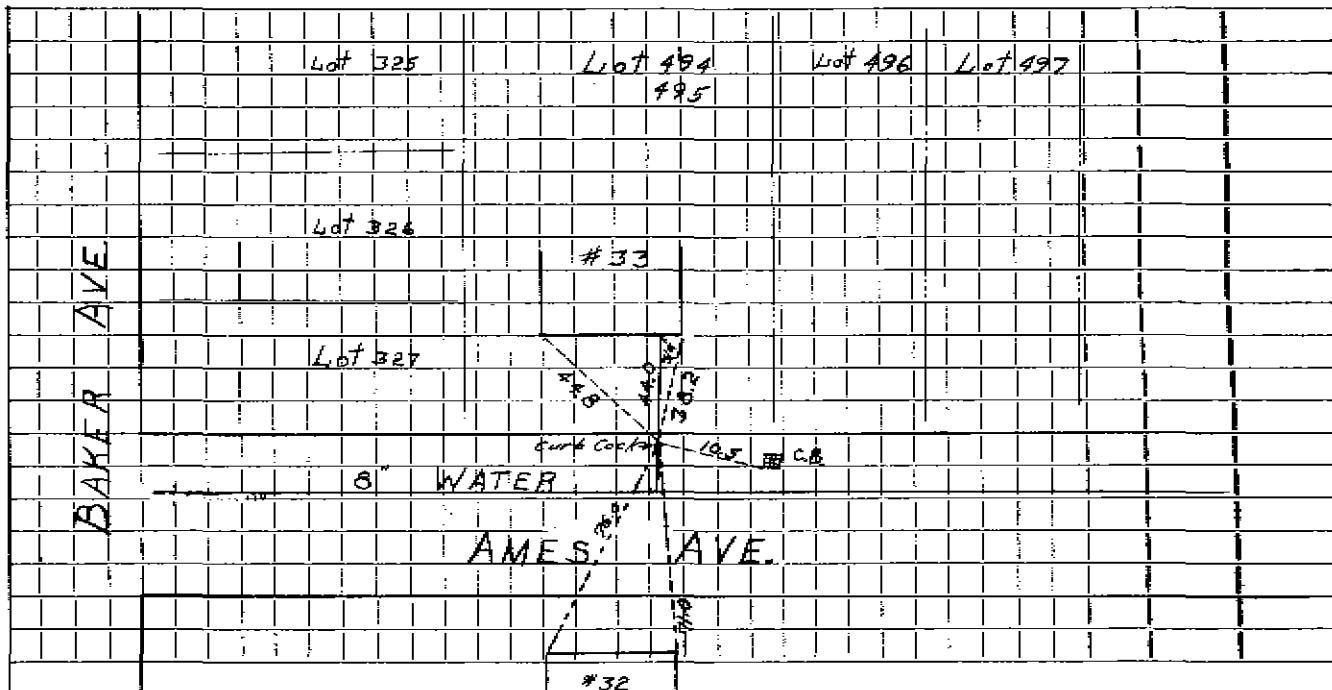

Connection made in ..... Street. #32 Work completed .....

Remarks: .....  
.....  
.....