

WATER SERVICE RECORD

1269
Service No. 56

Name David Lieb

Address 1 Ames Avenue

Location 1 Ames Avenue

Repair—Renewal—New Service
~~XXXXX~~ ~~XXXXXXXXXX~~ W.O. # 7093

APR 6 1970


| Date | Material | Amount | Total | Date | Amount |
|----------|---------------------|--------|-------|----------|--------------------------|
| 11/17/69 | Labor | | 26 66 | 11-2-69 | Deposit 100 00 |
| | 10% O.H. | | 2 67 | 4-6-70 | Refund 35 28 |
| 21' | 3/4" Copperpipe .79 | | 16 59 | | 64 22 |
| 1 | 3/4" Wheel Valve | | 9 30 | | |
| 1 | Hr. Trucking | | 3 00 | | <u>OUTSIDE</u> |
| 1 | Hr. Shovel | | 6 50 | 11/17/69 | Labor 39 99 |
| | | | 64 72 | 7' | 3/4" Copperpipe .79 5 53 |
| | | | | 1 | 3/4" Adaptor 2 76 |
| | | | | 1 | 3/4" Curb cock 11 32 |
| | | | | 1/2 | Ton Cold patch 5.85 1 47 |
| | | | | 2 | Hrs, Shovel 4.00 8 00 |
| | | | | 1 | " Trucking 3 00 |
| | | | | | <u>72 07</u> |

DATE _____

TOWN OF LEXINGTON -- BOARD OF PUBLIC WORKS

WATER DIVISION

Sketch of Service Here

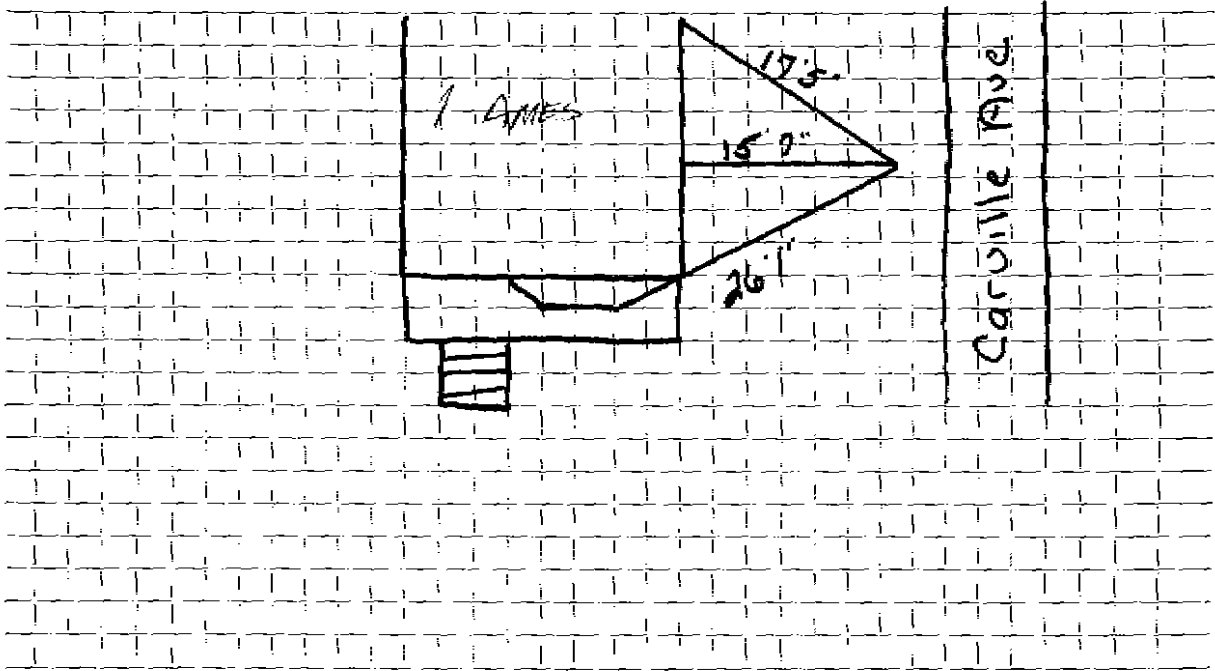

Connection made in Street. Work completed

Remarks:
.....
.....

WATER SERVICE RECORD

#1549

Name Thomas Walsh

Service No. 83

Address 6 Ames Avenue

Location

~~Repair - Rerunak~~ - New Service


Comm. 7/22/57

| Date | Material | Amount | Total | Date | Amount | |
|---------|----------------------------|--------|-------|---------|----------------------------|------------|
| 5/11/57 | Labor | 2 15 | | 5-7-57 | Deposit | 35 00 |
| | 10% overhead | 22 | 2 37 | 7-22-57 | Refund | 17 08 |
| | 35' - 3/4" Copper tubing @ | .4228 | 14 80 | | NON CHARGE | 17 92 |
| | 1 hr. Trucking | | 75 | 5/10/57 | Labor | 17 03 |
| | | | 17 92 | 5/11/57 | " | 69 67 |
| | | | | | | 86 70 |
| | | | | | 20' - 3/4" Copper tubing @ | .4228 8 46 |
| | | | | | 1 - 3/4" C. Corp Cock | 4 64 |
| | | | | | 1 - 3/4" C. Curb Cock | 5 94 |
| | | | | | 1 Box & Rod | 4 62 |
| | | | | | 3 hrs. @ .75 Trucking | 2 25 |
| | | | | | | 112 61 |

TOWN OF LEXINGTON — BOARD OF PUBLIC WORKS

WATER DIVISION

Sketch of Service Here

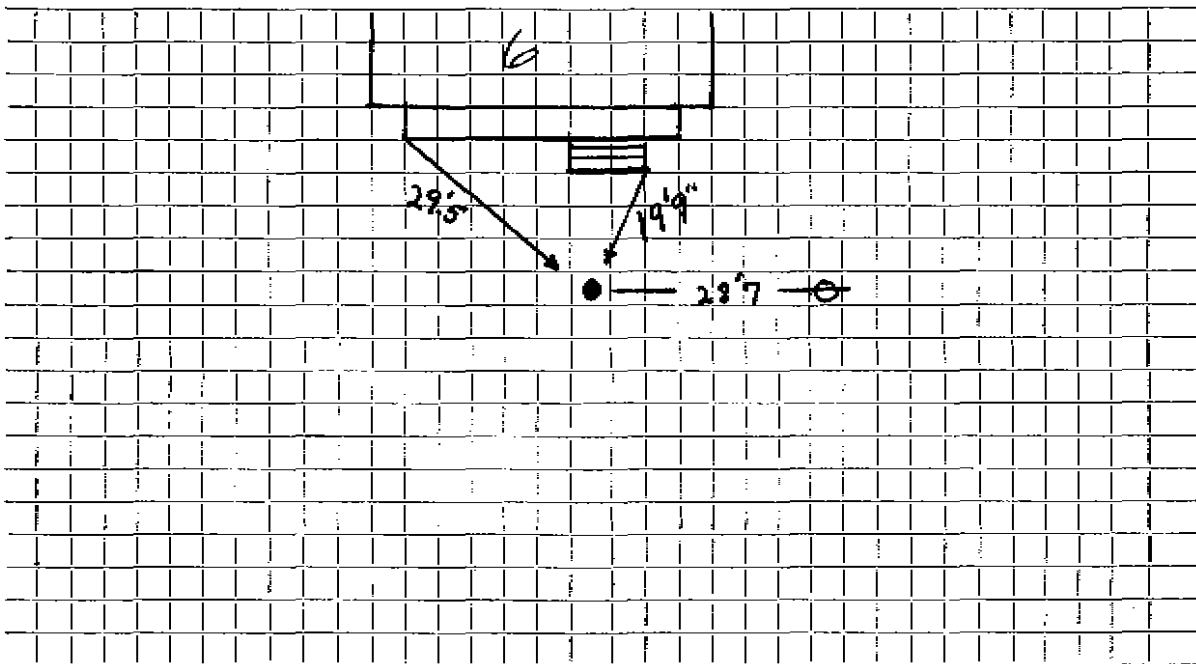

Connection made in Street. Work completed

Remarks:
.....
.....