

WATER SERVICE RECORD

Name Henry P. Hogan

Service No. 227

Address 7 Ames Ave.

Location

~~Repair~~ ~~Renewal~~ ~~New Service~~

Com. 8-31-53


Date	Material	Amount	Total	Date	Material	Amount
8/3/53	Labor	1 75		8-4-53	<i>Deposited</i>	15 00
	10% overhead	18	1 93	8-31-53	<i>Refunded</i>	3 97
	12' -3/4" copper tubing @ .3629		4 35			11 03
	1 -3/4" C x 3/8" I.W.H. stop & waste		4 00			
	1 hr. trucking		75			
			11 03			
	TRENCH DUG BY OWNER			11/6/52	<u>Outside</u> Labor	1 63
					15' 3/4" Copper tubing @ .34	5 10
					1 3/4" C. corp cock	4 33
					1 3/8" C x 3/4" C. curb cock	4 67
					1 3/4" C x 3/4" I. Union 2 pts.	1 09
						16 82

DATE _____

TOWN OF LEXINGTON — BOARD OF PUBLIC WORKS

WATER DIVISION

Sketch of Service Here

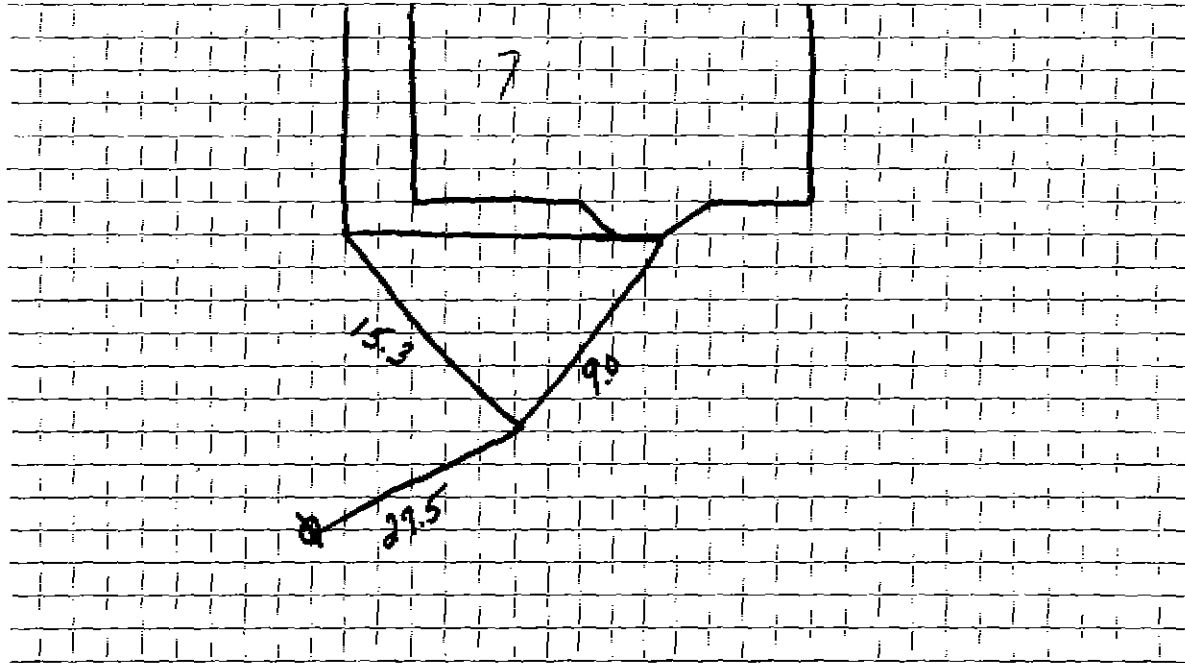

Connection made in Street. Work completed

Remarks:

.....
.....