

WATER SERVICE RECORD

Name Bernard Maloney

Service No. 51

Address 5 Amherst St.

Location

~~Repair - Renewal~~ New Service


Comm 5-4-59

Date	Material	Amount	Total	Date	Material	Amount	Total
4-15-59	Labor	12 21		4-15-59	Deposit	100 00	
	10% O. H.	1 22	13 43	5-4-59	Retard	31 75	
79'	3/4" Copper Tubing @.3666		28 96			68 25	
1	3/4" C x 1/8 I.W.H. Stop & Waste	5 84			NON CHARGE		
1	3/4" C 3 part Union	2 27	4-15-59	Labor	3 25		
2 1/8	Hrs. Town Shovel @6.50	16 25		21'	3/4" Copper Tube @.3666	7 70	
2	Hrs. Trucking @.75	1 50		1	3/4" C Corp Cock	4 64	
		68 25		1	3/4" C Carb Cock	6 03	
				1	Box & Rod	5 00	
				1	1/2 Straight Tailpiece	50	
				1	1/2 Offset Tailpiece	50	
				1/2	Hr. Town Shovel @6.50	3 25	
						30 87	

DATE \_\_\_\_\_

**TOWN OF LEXINGTON — BOARD OF PUBLIC WORKS**  
**WATER DIVISION**

Sketch of Service Here

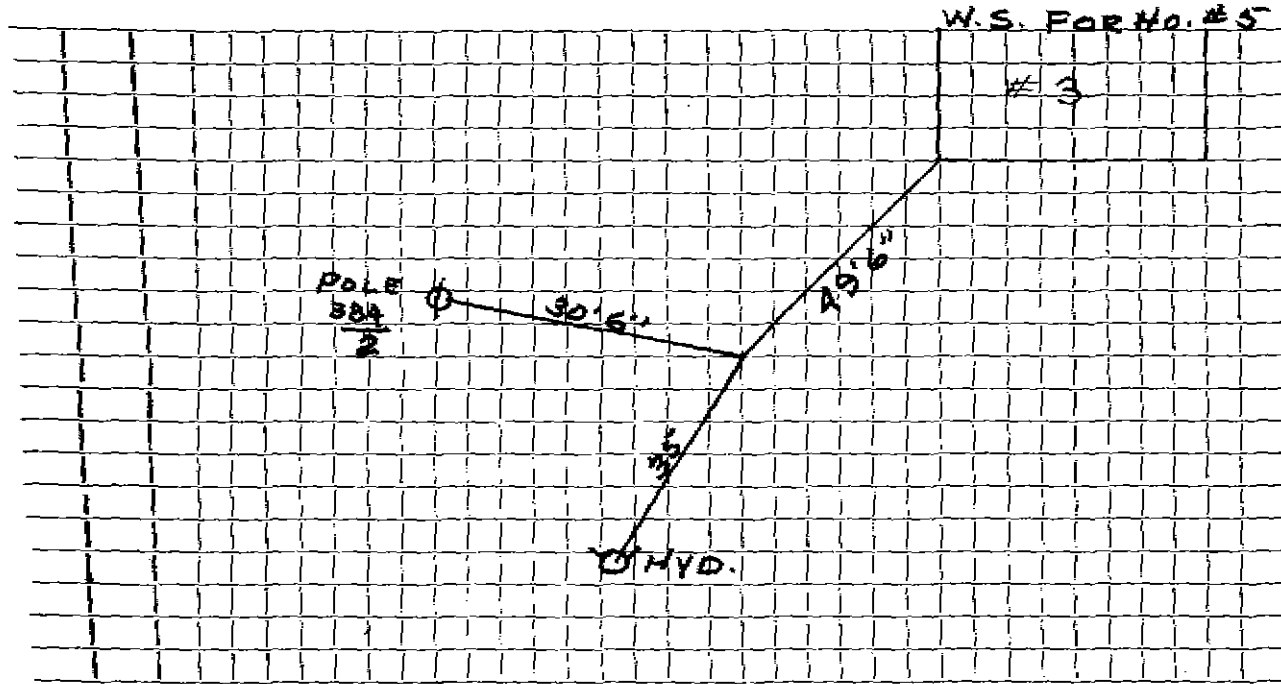

Connection made in \_\_\_\_\_ Street. Work completed \_\_\_\_\_

Remarks: \_\_\_\_\_

\_\_\_\_\_

\_\_\_\_\_