

#6100

WATER SERVICE RECORD

Name Oscar Carlson

Service No. 264

Address 7 Amherst Street

Location

~~Repair~~ ~~Renewal~~ ~~New Service~~

Comm 3-16-58


Date	Material	Amount	Total	Date	Amount
11/21/58	Labor	1 77		11-22-58	35 00
	10% overhead	18	1 95	3-16-59	199
	60' - 3/4" Copper tubing @ .37		22 20		33 91
	1 - 3/4" Cx 1/2 I.W.H. Stop & Waste		5 84		
	1 - 3/4" C. Union (3 part)		2 27		NON CHARGE
	1 hr. Trucking		75	11/22/58	17 58
			33 01	63' - 3/4" Copper tubing @ .37	23 31
				1 - 3/4" C. Corp Cock	4 64
				1 - 3/4" C. Curb Cock	6 03
				1 Box & Rod	5 00
				1 - 1/2 Straight tailpiece	50
				1 - 1/2 Offset tailpiece	50
				1 hr. trucking	75
					58 31

DATE \_\_\_\_\_

**TOWN OF LEXINGTON — BOARD OF PUBLIC WORKS**

**WATER DIVISION**

Sketch of Service Here

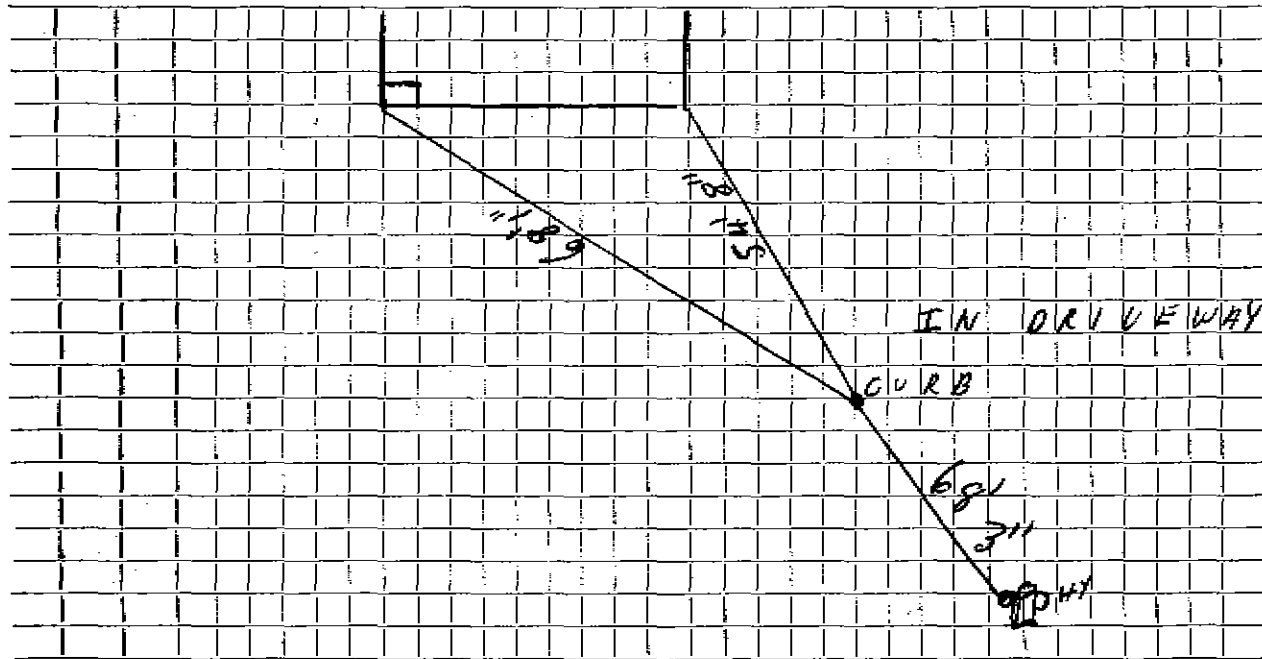

Connection made in ..... Street. Work completed .....

Remarks: .....  
.....  
.....