

**WATER SERVICE RECORD**

*3219*

Name Benjamin Franklin Homes, Inc.

Service No. #78

Address 10 Angier Road

Location

Repair ~~Renewal~~ New Service

WO #7363

*Comm 10-1-62*

Debits				Credits			
Date	Material	Amount	Total	Date	Material	Amount	Total
6-20-62	Labor	8.37		6-18-62	Deposit	25.00	
	10% O.H.	.84	9.21	10-1-62	Refund	23.61	
	80' 3/4" Copper tubing @.42		33.60				57.39
	1 3/4" C 1/2 X I.W.H. Stop & Waste		6.17				
	1 3/4" C3 Part Union		2.41				
			51.39	6-20-62	Labor	3.63	
					13' 3/4" Copper tubing @.42	5.46	
					1 3/4" C Corp Cock	4.91	
					1 3/4" Curb Cock	6.28	
					1 Box & Rod	4.90	
					1 1/2" Straight Tailpiece	.50	
					1 1/2" Offset Tailpiece	.50	
							26.18


*18.31 Applied to SAC #58*

DATE \_\_\_\_\_

TOWN OF LEXINGTON — BOARD OF PUBLIC WORKS

WATER DIVISION

Sketch of Service Here

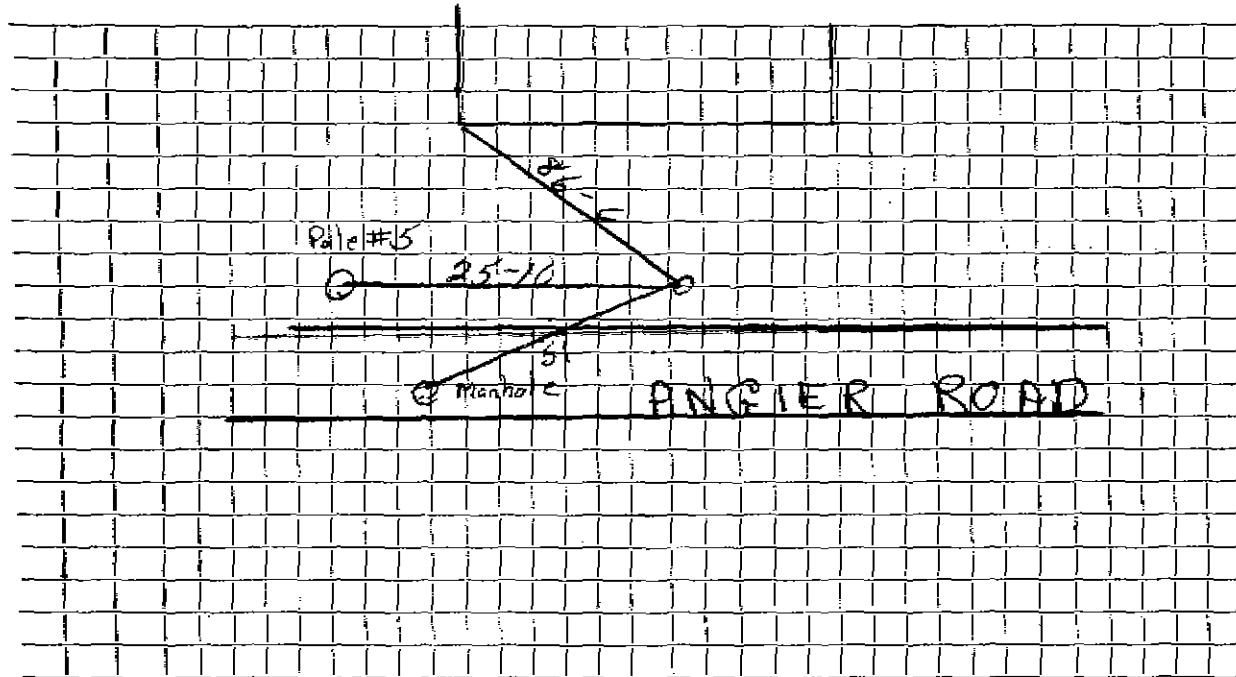

Connection made in ..... Street. Work completed .....

Remarks: .....

.....

.....