

## WATER SERVICE RECORD

4204

Name Benjamin Franklin Homes, Inc.

Service No. #57

Address 11 Angier Road

Location Lot #25 Sta. 7+13

~~Repair/Replace~~ New Service WO #7241


Comm 10-1-62

Date	Material	Amount	Total	Date	Amount	
	6' 3/4" Copper tubing @.42		2.52	5-15-62	Deposit	50.00
	BILL WHEN CONNECTED			10-1-62	Refund	2.65
7-6-62	Labor	2.13				47.35
	10% O.H.	.21	2.34			
75'	3/4" Copper Tubing @.42		31.50		NON CHARGE	
1	3/4" CX <sup>1</sup> / <sub>2</sub> I/W.H. Stop & Waste		6.17	5-4-62	Labor	3.64
2	3/4" C3 Part Union @2.41		4.82	29'	3/4" Copper tubing @.42	12.18
			47.35	1	3/4" C Corp Cock	4.91
				1	3/4" C Curb Cock	6.28
				1	Box & Rod	4.90
						31.91

DATE \_\_\_\_\_

**TOWN OF LEXINGTON — BOARD OF PUBLIC WORKS**  
**WATER DIVISION**

Sketch of Service Here

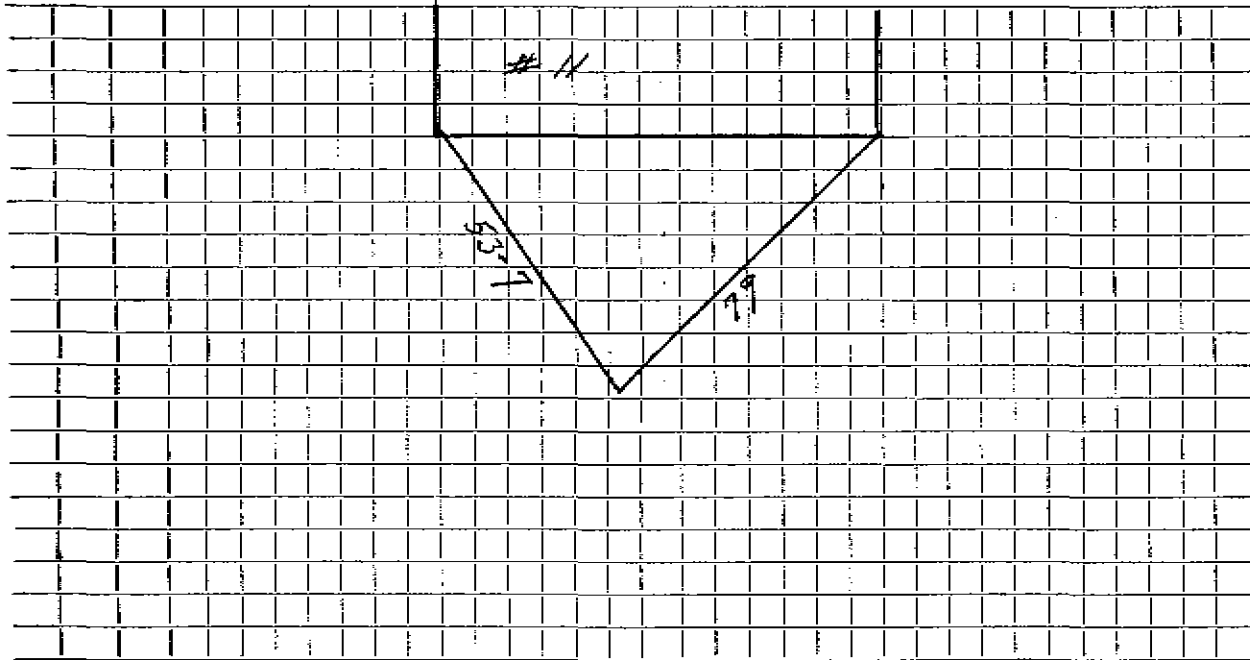

Connection made in ..... Street. Work completed .....

Remarks: .....  
.....  
.....