

WATER SERVICE RECORD

Name Ben Franklin Homes

Service No. 173

Address 2 Angier Road

Location Lot #16 Sta. 1+50

~~Repair Record~~ New Service

WO # 7768

Comm 8-26-63


Date	Material	Amount	Total	Date		Amount
4-17-63	Labor	2.77		12-6-62	Deposit	75.00
	10% O.H.	.28	3.05	8-26-63	Refund	18.99
94'	3/4" Copper tubing @.42		39.48			56.01
1	3/4" x 1/2 I.W.H. Stop & Waste		6.17		NON CHARGE	
1	3/4" C 3 part union		2.41	7-16-62	Labor	3.91
1	Box & Rod		<u>4.90</u>	18'	3/4" Copper tubing @.42	7.56
			56.01	1	3/4" C Corp Cock	4.91
				1	3/4" C Curb Cock	6.28
				1	Box & Rod	<u>4.90</u>
						27.56
				1	Straight tailpiece	.50
				1	Offset tailpiece	<u>.50</u>
						28.56

DATE _____

TOWN OF LEXINGTON — BOARD OF PUBLIC WORKS

WATER DIVISION

Sketch of Service Here

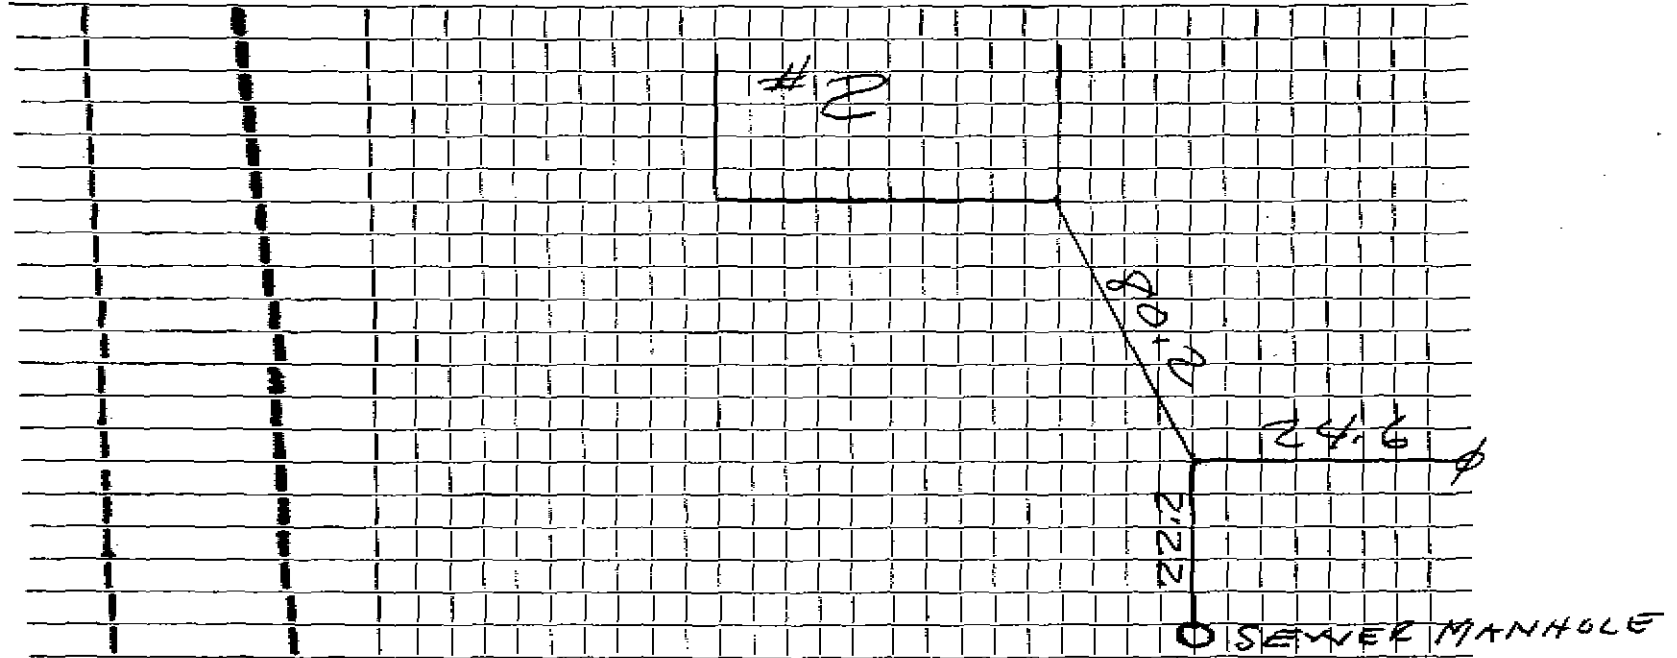

Connection made in _____ Street. Work completed 4/17/63

Remarks: SEWER VICE INSTALLED CURB TO HOUSE

B.V. BUILDER