

## WATER SERVICE RECORD

Name Benjamin Franklin Homes, Inc.

Service No. 163

Address 4 Angier Road

Location Lot #17 Sta. 2+71

XXXXXXXXXXXX  
 Repair—Renewal—New Service W.O.# 7719

Comm-1463


Date	Material	Amount	Total	Date		Amount
11-15-62	Labor	53.71		11-8-62	Deposit	200.00
	10% O.H.	5.37	59.08	1-14-63	Refund	24.53
170	3/4" Copper tubing @.42		71.40			172.47
1	3/4" CX 1/2 I.W.H. Stop & Waste		6.17			
2	3/4" 3 Part Unions @2.41		4.82		NON CHARGE	
2	Hrs. Town Shovel @6.50		13.00	7-16-62	Labor	3.63
3	Hrs. Trucking @3.00		9.00		30' 3/4" Copper tubing @.42	12.60
1	Hr. Allis Chalmers @5.00		5.00		1 3/4" C Corp Cock	4.91
1	Hr. Trailer @4.00		4.00		1 3/4" C Curb Cock	6.28
			172.47		1 Box & Rod	4.90
						32.32
				11-15-62	1 1/2 Straight Tailpiece	.50
					1 1/2 Offset Tailpiece	.50
						33.32

DATE \_\_\_\_\_

# TOWN OF LEXINGTON — BOARD OF PUBLIC WORKS

## WATER DIVISION

Sketch of Service Here

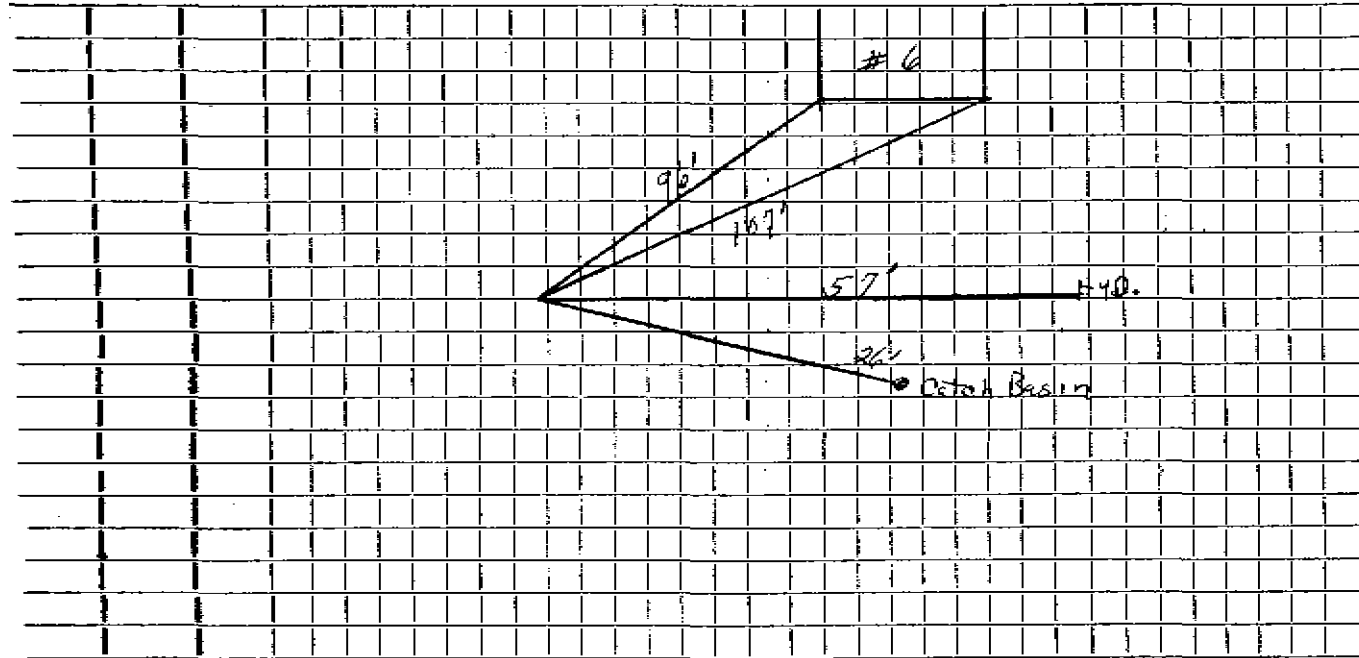

Connection made in \_\_\_\_\_ Street. Work completed \_\_\_\_\_

Remarks: \_\_\_\_\_  
\_\_\_\_\_  
\_\_\_\_\_