

WATER SERVICE RECORD

Name Benjamin Franklin Homes, Inc.

Service No. ~~109~~ 117

Address 5 Angier Road

3425

Location Lot #23 Sta. #3+36

Repair—Renewal—New Service

WG # 2579

Comm 10-29-62


Date	Material	Amount	Total	Date	Material	Amount
9-7-62	Labor	4.26				
	10% O.H.	.43	4.69	8-31-62	Deposit	50.00
	100' 3/4" Copper tubing @.42		42.00	11-5-62		7.68
1	3/4" CX 1/2 I.W.H. Stop & Waste		6.17			57.68
2	3/4" C3 Part Union @2.41		4.82		NON CHARGE	
			57.68	7-17-62	Labor	4.34
					32' 3/4" Copper tubing @.42	13.44
					1 3/4" C Corp Cock	4.91
					1 3/4" C Curb Cock	6.28
					1 3/4" C 3 part union	2.41
					1 Box & Rod	4.90
						36.28
				9-7-62	1 1/2" Straight Tailpiece	.50
					1 1/2" Offset Tailpiece	.50
						37.28

DATE _____

TOWN OF LEXINGTON — BOARD OF PUBLIC WORKS

WATER DIVISION

Sketch of Service Here

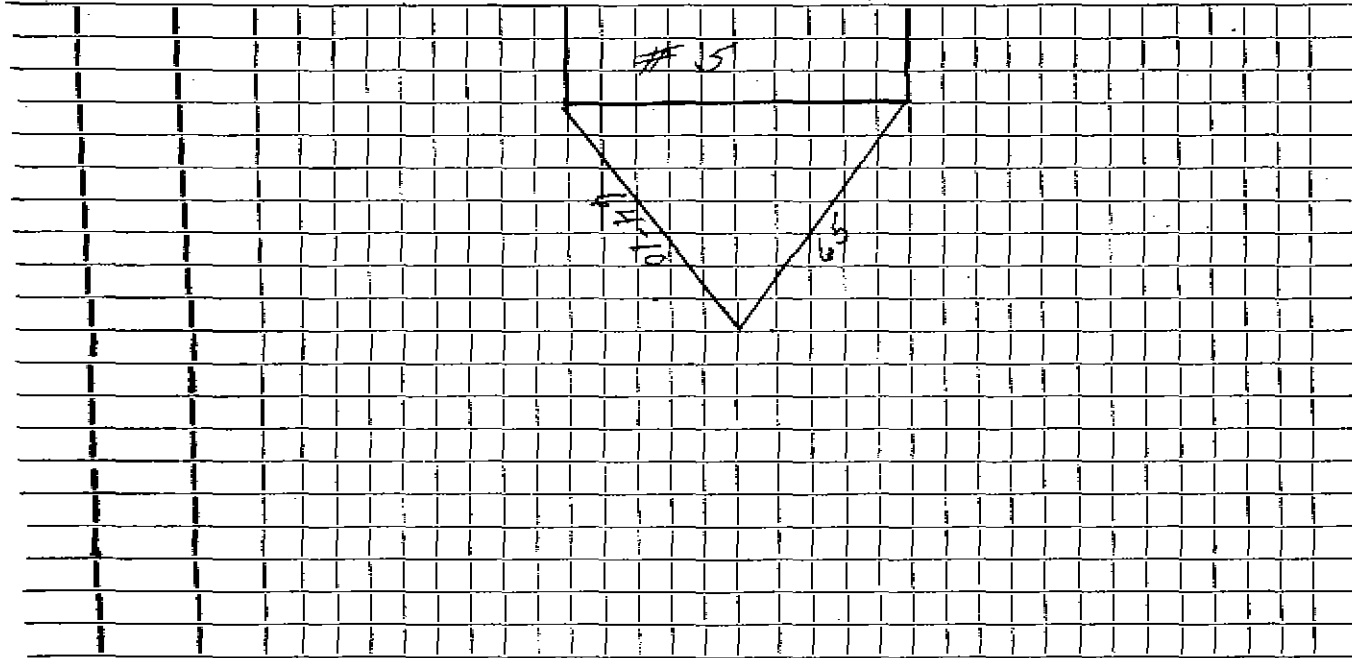

Connection made in _____ Street. Work completed _____

Remarks: _____
