

6719

WATER SERVICE RECORD

Name Benjamin Franklin Homes, Inc.

Service No. #38

Address 6 Angier Road

Location

Repair—Renewal—New Service WO #7181

Comm 6-25-62


Date	Material	Amount	Total	Date	Amount	
5-4-62	Labor	4.26		4-25-62	Deposit	50.00
	10% O.H.	.43	4.69	6-25-62	Refund	97
	78' 3/4" Copper tubing @.42		32.76			49.03
	1 3/4" Cx 1/2 I.W.H. Stop & Waste		6.17			
	1 3/4" C3 Part Union		2.41		Non Charge	
	1 Hr. Trucking @3.00		3.00	5-4-62	15' 3/4" Copper tubing @.42	6.30
			49.03		1 3/4" C Corp Cock	4.91
					1 3/4" C Curb Cock	6.28
					1 1/2 Straight Tailpiece	.50
					1 1/2 Offset Tailpiece	.50
					Labor	4.26
						22.75

DATE _____

TOWN OF LEXINGTON — BOARD OF PUBLIC WORKS

WATER DIVISION

Sketch of Service Here

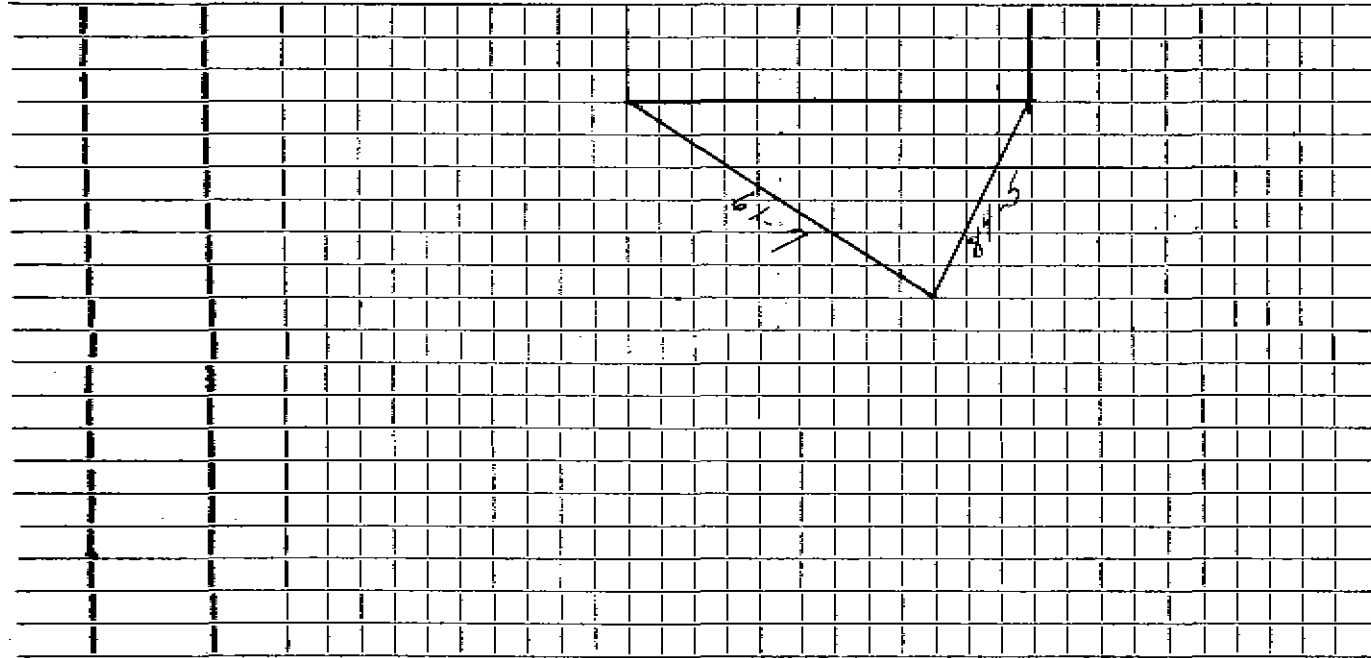

Connection made in _____ Street. Work completed _____

Remarks: _____

