

WATER SERVICE RECORD

2038

Service No. #56

Name Benjamin Franklin Homes, Inc.

Address 7 Angier Road

Location Lot #24 Sta. 4+91

~~Repair - Break~~ New Service WO #7240

Comm 10-1-62


Date	Material	Amount	Total	Date	Amount
7-5-62	Labor	2.41		5-15-62	Deposit 50.00
	10% O.H.	.24	2.65	10-1-62	Refund 18.50
	54' 3/4" Copper tubing @.42		22.68		31.50
	1 3/4" CX 1/2 I.W.F. Stop & Waste		6.17		
			31.50		
	OWNER DUG TRENCH				
				7-5-62	Labor 2.13
					20' 3/4" Copper Tubing @.42 11.76
					1 3/4" C Corp Cock 4.91
					1 3/4" C Curb Cock 6.28
					1 Box & Rod 4.90
					1 1/2 Straight Tailpiece .50
					1 1/2 Offset Tailpiece .50
					30.98

TOWN OF LEXINGTON — BOARD OF PUBLIC WORKS

WATER DIVISION

DATE _____

Sketch of Service Here

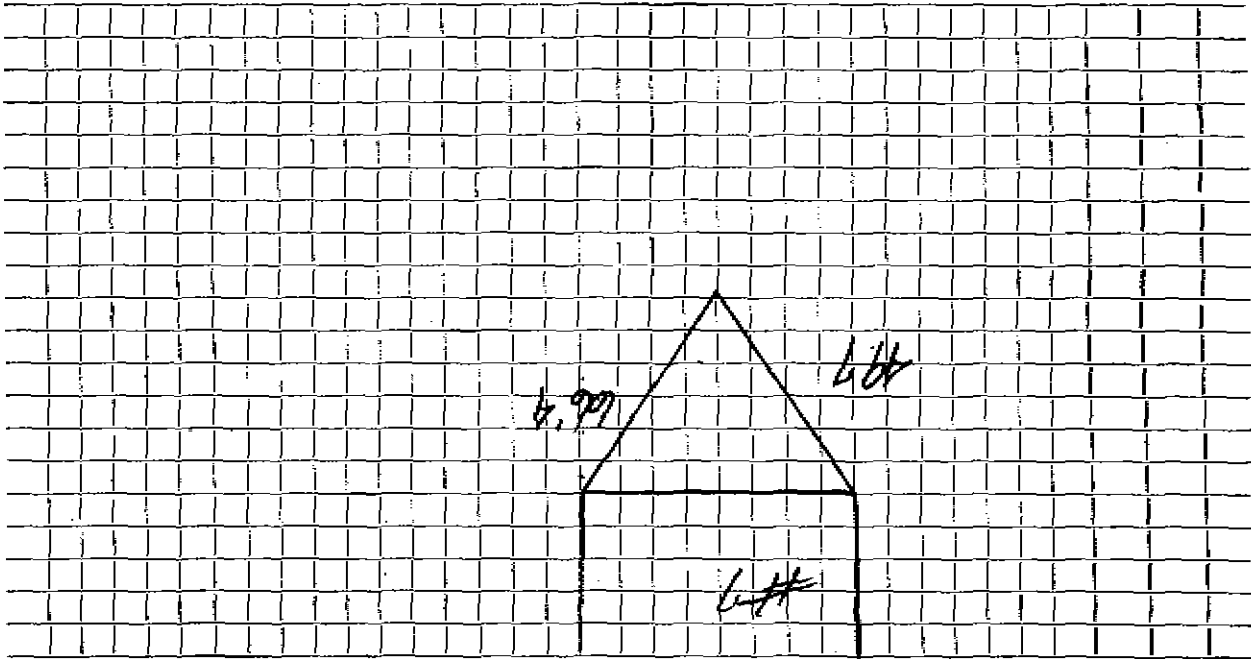

Connection made in _____ Street. Work completed _____

Remarks: _____