

WATER SERVICE RECORD

Service No. 333

Name Antonio Busa

Address 3 Anthony Road

3307

Location

Repairs ~~Renewal~~ - New Service

Comm. 4/1/57


Date	Material	Amount	Total	Date	Amount
10/26/56	Labor	1 76		11-1-56	Deposit \$ 50 00
	10% overhead	18	1 94	4-1-57	Refund 21 18
	43' - 3/4" Copper tubing @ .4396	18 90			NON CHARGE \$ 28 82
	1 - 3/4Cx $\frac{1}{2}$ I.W.H. Stop & Waste		4 96	1 - $\frac{1}{2}$ "	Straight tailpiece 50
	1 3/4" C. Union (3 part)		2 27	1 - $\frac{1}{2}$ "	Offset tailpiece 50
	1 hr. trucking		75		1 00
			28 82		<u>Outside</u>
				8/24/56	Labor 1 95
				15'	3/4" Copper tubing @ .4396 6 59
				1	3/4" C Corp cock 4 64
				1	3/4" C Curb Cock 5 94
				1	Box & Rod 4 62
					23 74
					Total 24 74

DATE _____

TOWN OF LEXINGTON — BOARD OF PUBLIC WORKS

WATER DIVISION

Sketch of Service Here

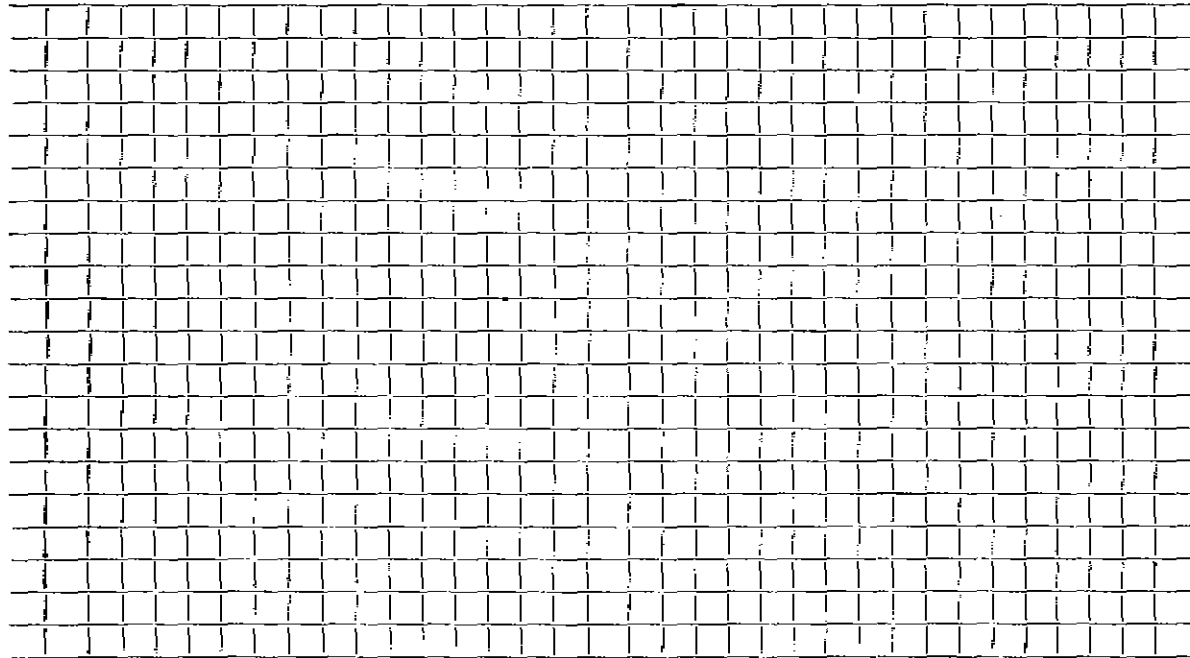

Connection made in Street, Work completed

Remarks:
.....
.....