

WATER SERVICE RECORD

5792

Name Kelly Corp.

Service No. 243

Address 10 Appletree Lane

Location Lexington

~~REPAIR~~ ~~RENEWAL~~ - New Service

Com. 12-1-52


Date	Material	Amount	Total	Date	Amount
10/28/52	Labor	1 63		10-9-52 Deposited	10 -
	10% overhead	16	1 79	12-1-52 Refunded	72
	3' - 3/4" copper tubing @ .34		1 02		NON CHARGE
	1 - 3/4" C x 1/8 I.W.H. stop & waste		4 00	10/28/52 Labor	3 83
	1 - 3/4" C x 3/4" union		1 72	3' - 3/4" copper tubing @ .34	3 06
	1 hr. trucking		75	1 - 3/4" C. corp-cock	4 33
			9 28	1 - 3/4" C x 3/4" C. curb-cock	4 67
	TRENCH DUG BY OWNER			1 box and r cd	3 90
	PIPE SUPPLIED AND LAID BY OWNER			1 - 1/2 offset tail piece	50
				1 - 1/2 straight tail piece	50
				1 hr. trucking	75
					21 54

DATE _____

TOWN OF LEXINGTON — BOARD OF PUBLIC WORKS

WATER DIVISION

Sketch of Service Here

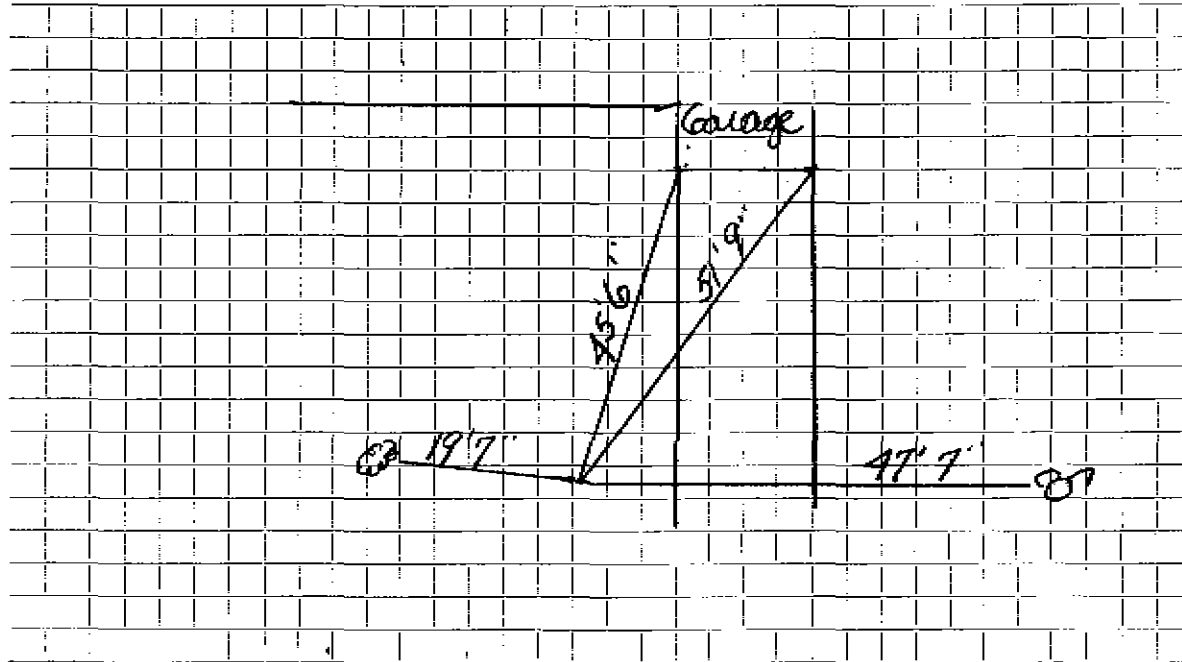

Connection made in Street. Work completed

Remarks:
.....
.....