

WATER SERVICE RECORD

Name Kelly Corp.

Service No. 244

Address 11 Appletree Lane

4607, 7383

Location Lexington

~~DOING BUSINESS~~ - New Service

Com. 12-1-52


| Date | Material | Amount | Total | Date | Amount |
|----------|------------------------------------|--------|-------|--------------------------------|--------|
| 10/30/52 | Labor | 1 63 | | 10-9-52 Deposited | 10 - |
| | 10% overhead | 16 | 1 79 | 12-1-52 Refunded | (3 46) |
| | 1 -3/4" Cx 1/2 I.W.H. stop & waste | | 4 00 | NON CHARGE | 6 54 |
| | 1 hr. trucking | | 75 | 10/30/52 Labor | 2 19 |
| | | | 6 54 | 26' - 3/4" copper tubing @ .34 | 8 84 |
| | TRENCH DUG BY OWNER | | | 1 -3/4" C.curb-cock | 4 33 |
| | PIPE SUPPLIED & LAID BY OWNER | | | 1 -3/4" Cx 3/4" C.curb-cock | 4 67 |
| | | | | 1 box and rod | 3 90 |
| | | | | 1 -1/2 straight tail piece | 50 |
| | | | | 1 -1/2 offset tail piece | 50 |
| | | | | 1 hr. trucking | 75 |
| | | | | | 25 68 |

DATE _____

TOWN OF LEXINGTON — BOARD OF PUBLIC WORKS

WATER DIVISION

Sketch of Service Here

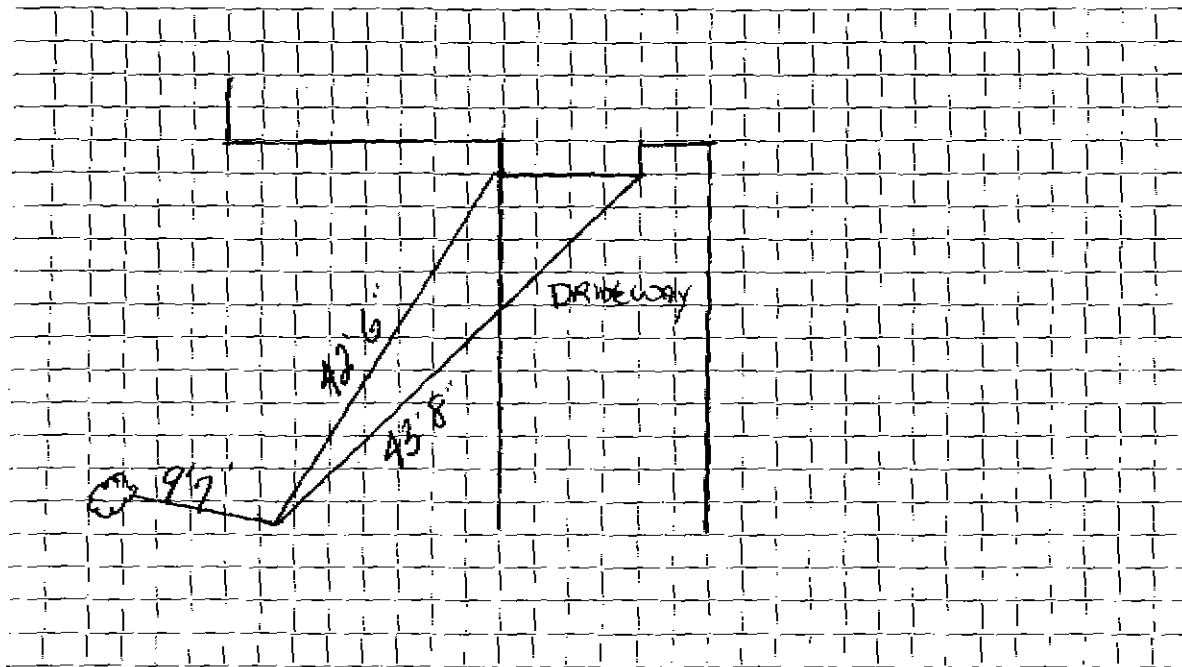

Connection made in Street. Work completed

Remarks:

.....

.....