

WATER SERVICE RECORD

Name Kelly Corp.

Service No. 245

Address 12 Appletree Lane

Location Lexington

Repair ~~XXXXXX~~ - New Service

Com. 12-1-52


Date	Material	Amount	Total	Date	Amount
10/30/52	Labor	1 63		10-9-52	Deposited 10 -
	10% overhead	16	1 79	12-1-52	Refunded 3 46
	1 -3/4" Cx 1/8 I.W.H. stop & waste	4 00			NON CHARGE 6 54
	1 hr. trucking		75	10/30/52	Labor 2 19
			6 54	12' - 3/4" copper tubing@ .34	4 08
	TRENCH DUG BY OWNER			1 -3/4" C.curb-cock	4 33
	PIPE SUPPLIED & LAID BY OWNER			1 -3/4" Cx 3/4" C.curb-cock	4 67
				1 box and rod	3 90
				1 -1/2 straight tail pc.	50
				1 -1/2 offset tail pc.	50
				1 hr. trucking	75
					<u>20 92</u>
				7-7-55	Broken Service

DATE _____

TOWN OF LEXINGTON — BOARD OF PUBLIC WORKS

WATER DIVISION

Sketch of Service Here

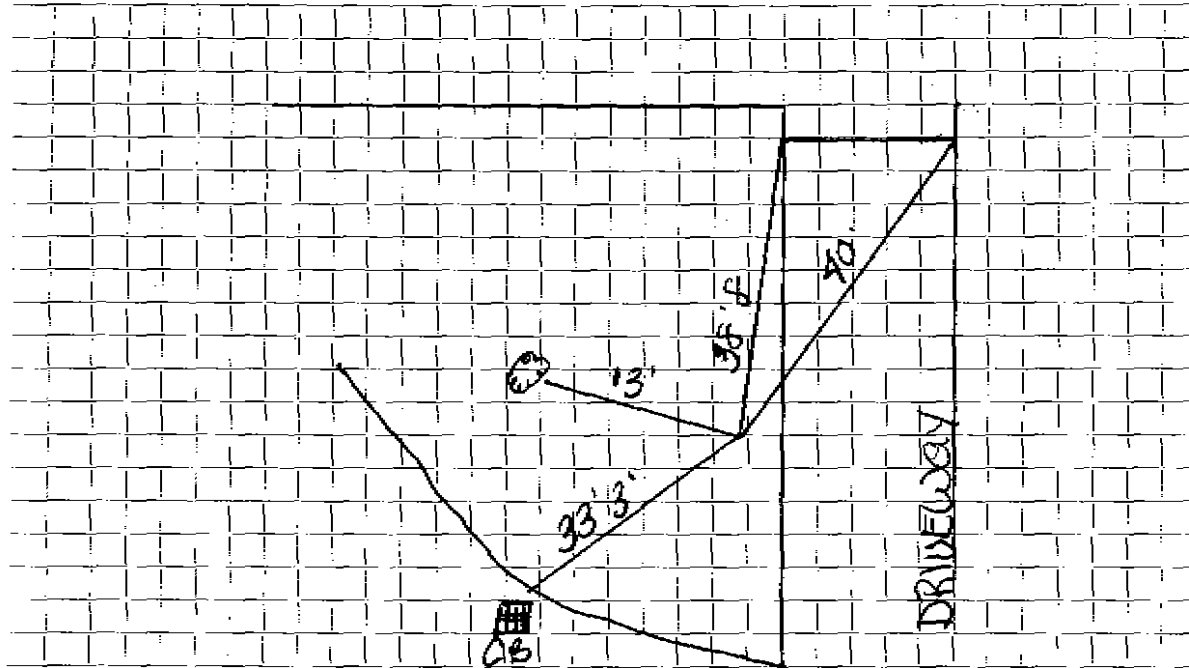

Connection made in _____ Street. Work completed _____

Remarks: _____
