

WATER SERVICE RECORD

Name Kelly Corp.

Service No. 246

Address 13 Appletree Lane

Location Lexington

Repair ~~Renewal~~  New Service


*Com. 12-1-52*

Date	Material	Amount	Total	Date	Amount
10/30/52	Labor	1 63		10-9-52 Deposited	10 -
	10% overhead	16	1 79	12-1-52 Refunded	(3) 46
	1 -3/4" Cx 1/2 I.W.H. stop & waste	4 00		NON CHARGE	6 54
	1 hr. trucking		75	10/30/52 Labor	2 19
			6 54	23' -3/4" copper tubing @ .34	7 82
	TRENCH DUG BY OWNER			1 -3/4" C. curb-cock	4 33
	PIPE SUPPLIED & LAID BY OWNER			1 -3/4" Cx 3/4" C. curb-cock	4 67
				1 box and rod	3 90
				1 -1/2 straight tail pc.	50
				1 -1/2 offset tail pc.	50
				1 hr. trucking	75
					24 66

DATE \_\_\_\_\_

**TOWN OF LEXINGTON — BOARD OF PUBLIC WORKS**  
**WATER DIVISION**

Sketch of Service Here

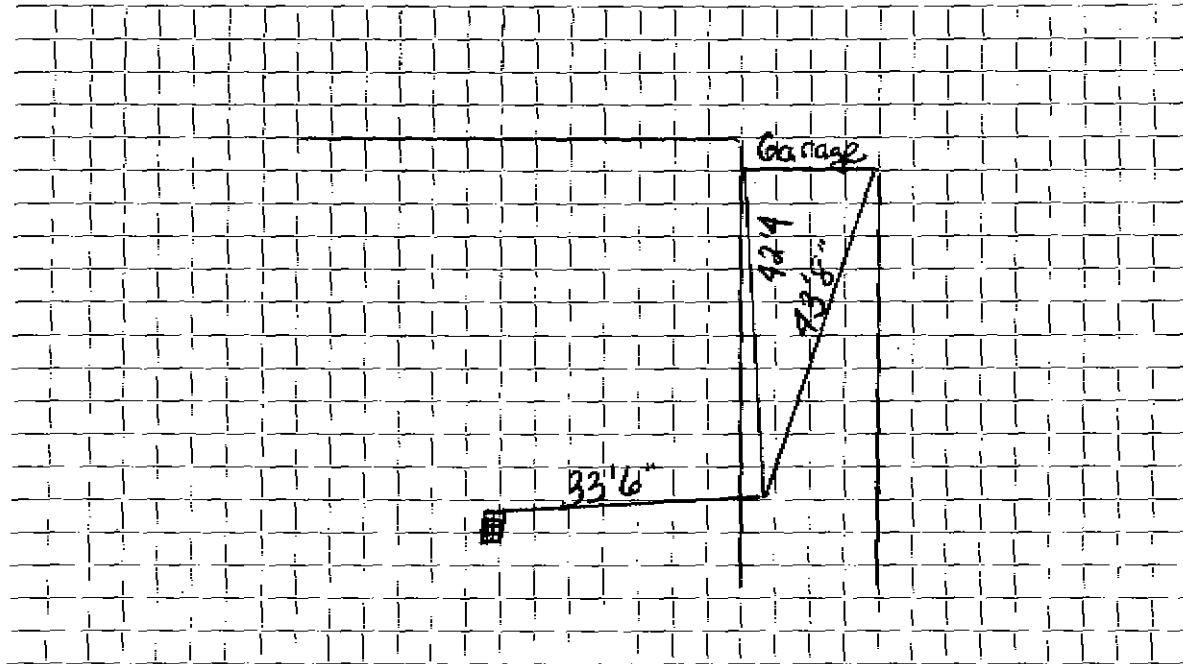

Connection made in ..... Street. Work completed .....

Remarks: .....

.....

.....