

WATER SERVICE RECORD

6059

Name Kelly Corp.

Service No. 247

Address 14 Appletree Lane

Location Lexington

Repair ~~Work~~ - New Service

Com. 12-1-52


Date	Material	Amount	Total	Date	Amount
10/28/52	Labor	1 63		10-9-52	Deposited 10 -
	10% overhead	16	1 79	12-1-52	Refunded 3 46
	1 -3/4" C x 1/2 I.W.H. stop & waste	4 00			NON CHARGE 6 54
	1 hr. trucking		75	10/28/52	Labor 2 20
			6 54	15' - 3/4" copper tubing @ .34	5 10
	TRENCH DUG BY OWNER			1 -3/4" C.curb-cock	4 33
	PIPE SUPPLIED AND LAID BY OWNER			1 -3/4" Cx 3/4" C.curb-cock	4 67
				1 box and rod	3 90
				1 -1/2 straight tail pc.	50
				1 -1/2 offset tail pc.	50
				1 hr. trucking	75
					<u>21 95</u>

DATE _____

TOWN OF LEXINGTON — BOARD OF PUBLIC WORKS

WATER DIVISION

Sketch of Service Here

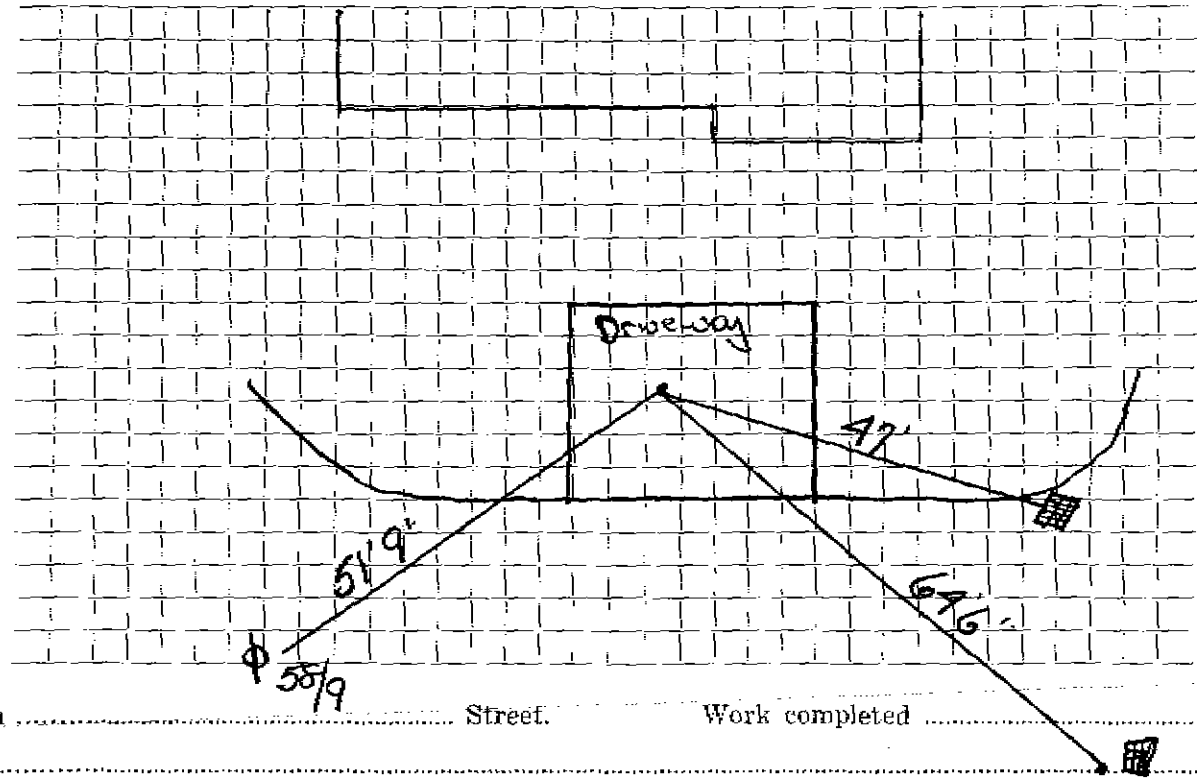

Connection made in _____ Street. Work completed _____

Remarks: _____
