




DATE MAY 22 1998

TOWN OF LEXINGTON — BOARD OF PUBLIC WORKS

WATER DIVISION

Sketch of Service Here

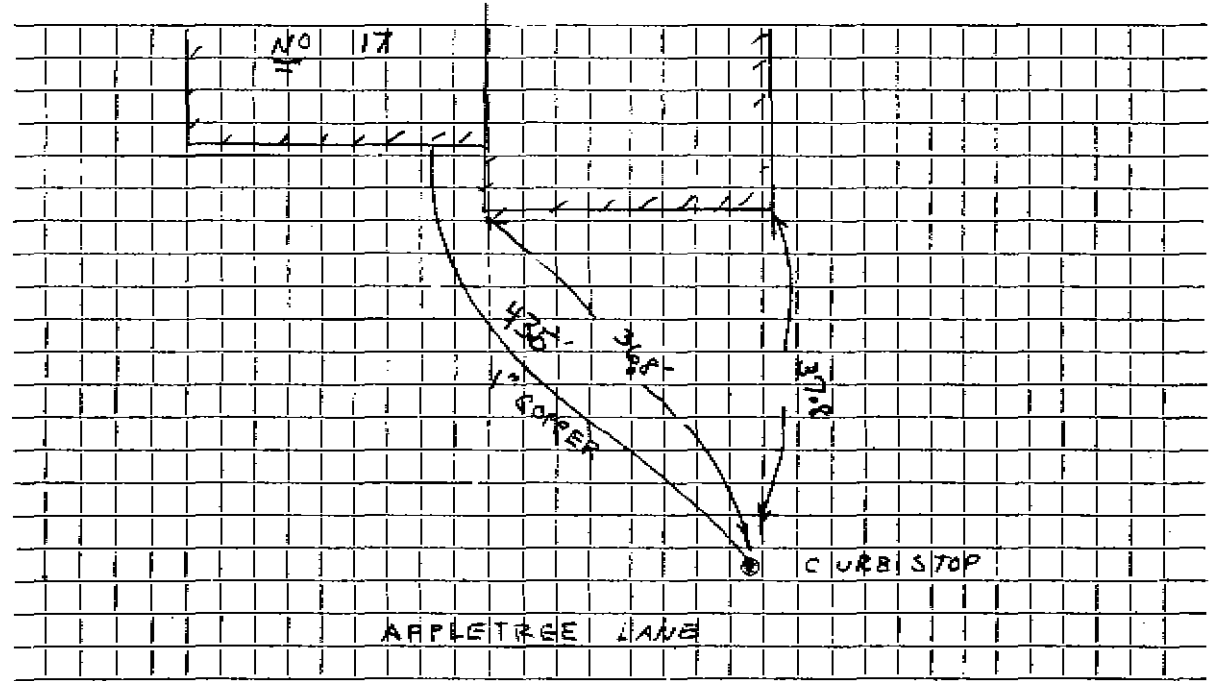

Connection made in APPLETREE LANE Street.

Work completed CIMINA CONTRACTING

Remarks: .....

FIELD BOOK 98-2

TJM

WATER SERVICE RECORD

Name Kelly Corp.

Service No. 249

Address 17 Appletree Lane

# 6669

Location Lexington

~~Repair~~ ~~Renewal~~ - New Service

*Am. 12-1-52*


Date	Material	Amount	Total	Date	Amount
10/30/52	Labor	1 63		11-9-52	10 -
	10% overhead	16	1 79	12-1-52	3 46
	1 -3/4" Cx 1 1/2 I.W.H. stop & waste	4 00			NON CHARGE
	1 hr. trucking		75	10/30/52	Labor
			6 54		2 20
				32' - 3/4" copper tubing @ .34	10 88
	TRENCH DUG BY OWNER			1 -3/4" C.curb-cock	4 33
	PIPE SUPPLIED & LAID BY OWNER			1 -3/4" C x 3/4" C.curb-cock	4 67
				1 box and rod	3 90
				1 -1/2 straight tail piece	50
				1 -1/2 offset tail piece	50
				1 hr. trucking	75
					27 73

DATE \_\_\_\_\_

TOWN OF LEXINGTON — BOARD OF PUBLIC WORKS

**WATER DIVISION**

Sketch of Service Here

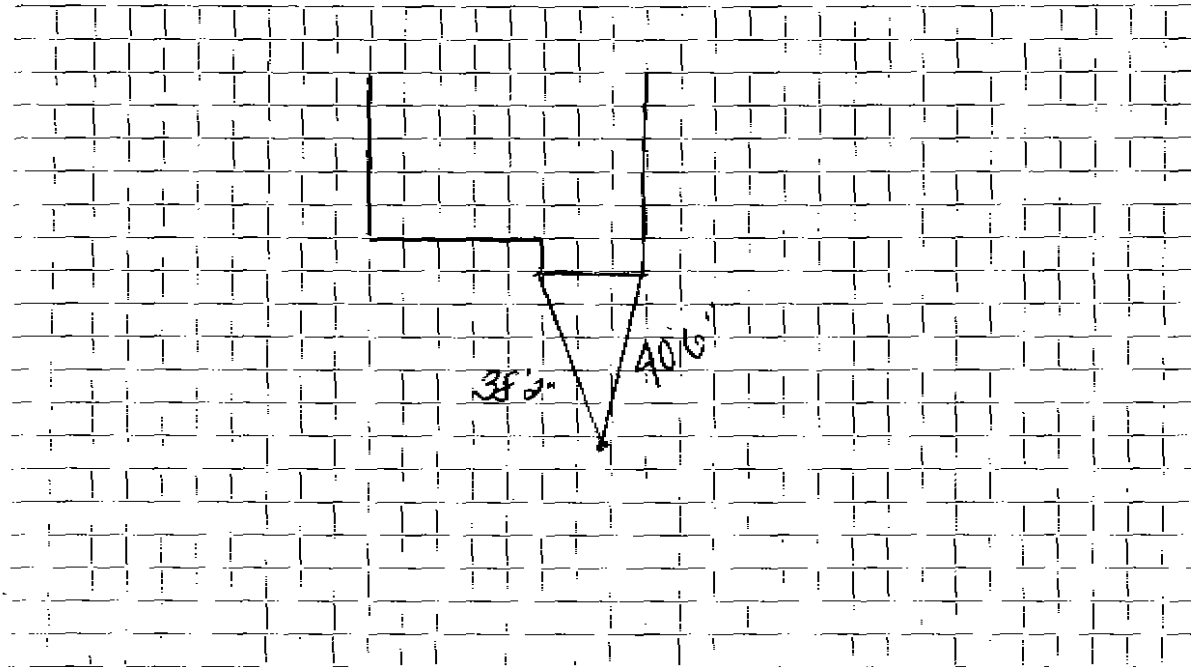

Connection made in ..... Street. Work completed .....

Remarks: .....

.....

.....