

WATER SERVICE RECORD

Name Kelly Corp.

Service No. 250

Address 19 Appletree Lane

3318

Location Lexington

Repair ~~Renewal~~ - New Service

Com. 12-1-52


Date	Material	Amount	Total	Date	Amount
10/28/52	Labor	1 63		11-9-52	10 -
	10% overhead	16	1 79	12-1-52	3 46
	1 -3/4" Cx 1/2 I.W.H. stop & waste	4 00			NON CHARGE
	1 hr. trucking		75	10/28/52 Labor	3 83
			6 54	21' -3/4" copper tubing @ .34	7 14
	TRENCH DUG BY OWNER			1 -3/4" C.curb-cock	4 33
	PIPE SUPPLIED & LAID BY OWNER			1 - 3/4" Cx 3/4" C.curb-cock	4 67
				1 - box and rod	3 90
				1 - 1/2 straight tail piece	50
				1 - 1/2 offset tail piece	50
				1 hr. trucking	75
					25 62

DATE _____

TOWN OF LEXINGTON — BOARD OF PUBLIC WORKS

WATER DIVISION

Sketch of Service Here

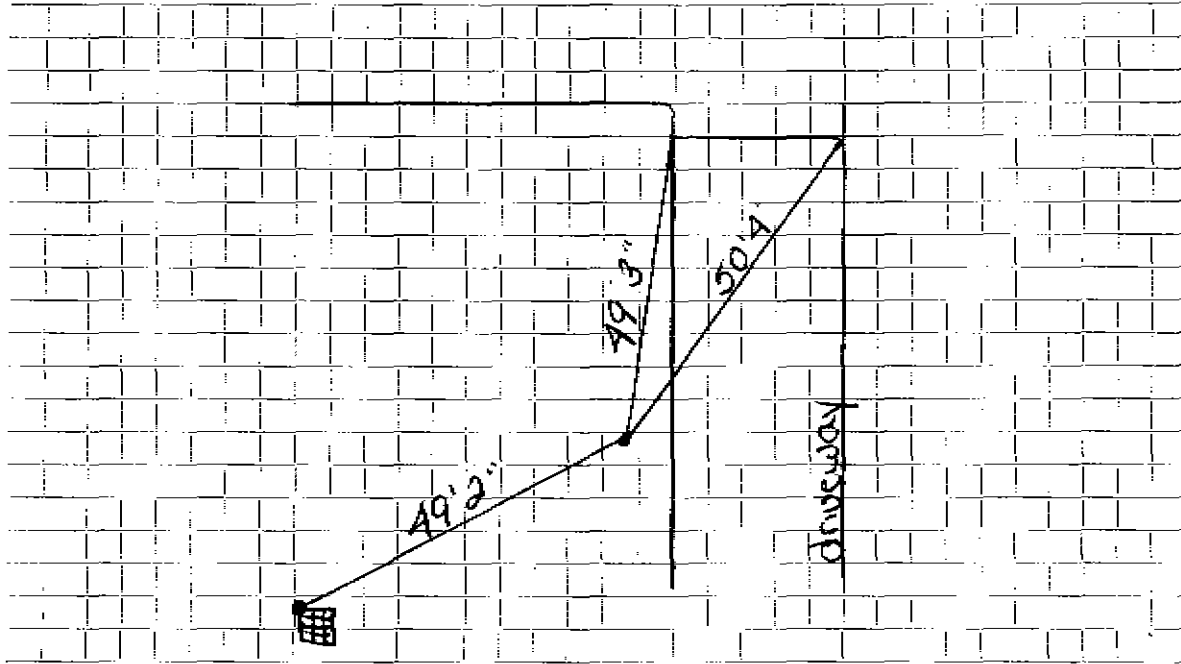

Connection made in Street. Work completed

Remarks:

.....

.....