

WATER SERVICE RECORD

Name Kelly Corp.

Service No. 238

Address 3 Appletree Lane

Location Lexington

~~Repair/ Renewal~~ - New Service

*Com. 12-1-52*


Date	Material	Amount	Total	Date	Amount
10/29/52	Labor	1 63		10-9-52	Deposited 10 00
	10% overhead	16	1 79	12-1-52	Refunded (346)
	1 -3/4" C x 1/2 I.W.F. stop& waste		4 00		NON CHARGE 6 54
	1 hr. trucking		75	10/29/52	Labor 3 15
			6 54	24' - 3/4" copper tubing@ .34	8 16
	TRENCH DUG BY OWNER			1 -3/4" C. corp-cock	4 33
	PIPE SUPPLIED AND LAID BY OWNER			1 -3/4" C. curb-cock	4 67
				1 box and rod	3 90
				1 -1/2 straight tail piece	50
				1 -1/2 offset tail piece	50
				1 hr. trucking	75
					<u>25 96</u>
				5/7/81	3/4 Corp
					2' 7/8 COPPER
					1 Style 88 Union

DATE \_\_\_\_\_

TOWN OF LEXINGTON — BOARD OF PUBLIC WORKS

WATER DIVISION

Sketch of Service Here

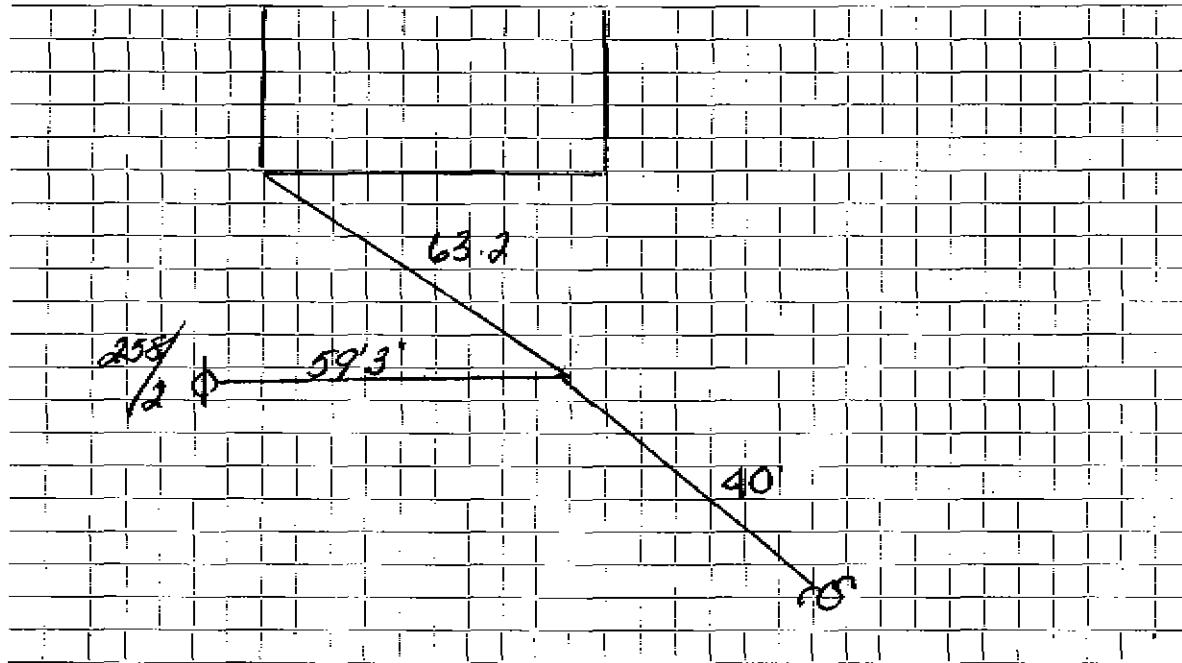

Connection made in ..... Street. Work completed .....

Remarks: .....

.....

.....