

WATER SERVICE RECORD

711

Name Kelly Corp.

Service No. 242

Address 9 Appletree Lane

Location Lexington

~~Repair~~ ~~Renewal~~ New Service

Com. 12-1-52


Date	Material	Amount	Total	Date	Amount
10/30/52	Labor	1 63		10-9-52 Deposited	10 -
	10% overhead	16	1 79	12-1-52 Refunded	(3 46)
	1 - 3/4" C x 1/2 I.W.H. stop & waste	4 00			NON CHARGE
	1 hr. trucking		75	10/30/52 Labor	2 20
			6 54	23' - 3/4" copper tubing @ .34	7 82
	TRENCH DUG BY OWNER			1 - 3/4" C. corp-cock	4 33
	PIPE SUPPLIED AND LAID BY OWNER			1 - 3/4" Cx 3/4" C. curb-cock	4 67
				1 box and rod	3 90
				1 - 1/2 straight tail pc.	50
				1 - 1/2 offset tail pc.	50
				1 hr. trucking	75
					24 67

DATE _____

TOWN OF LEXINGTON — BOARD OF PUBLIC WORKS

WATER DIVISION

Sketch of Service Here

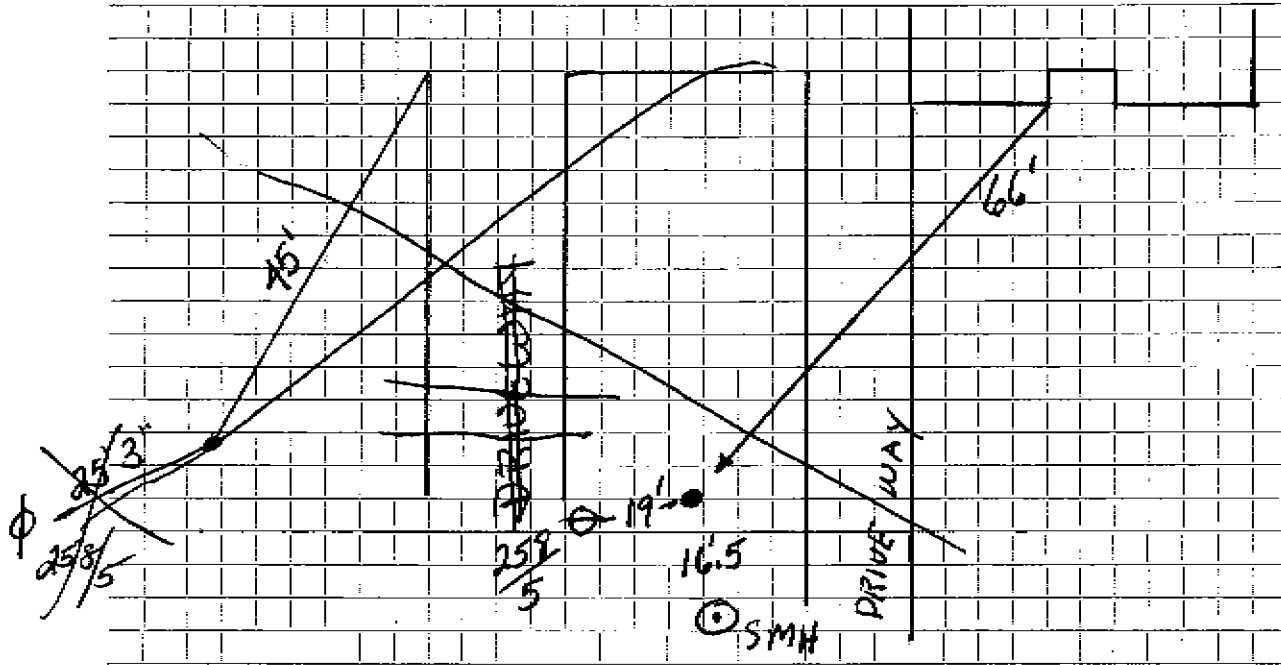

Connection made in Street. Work completed

Remarks:

.....
.....