


TOWN OF LEXINGTON - BOARD OF PUBLIC WORKS
WATER DIVISION

SKETCH OF SERVICE HERE

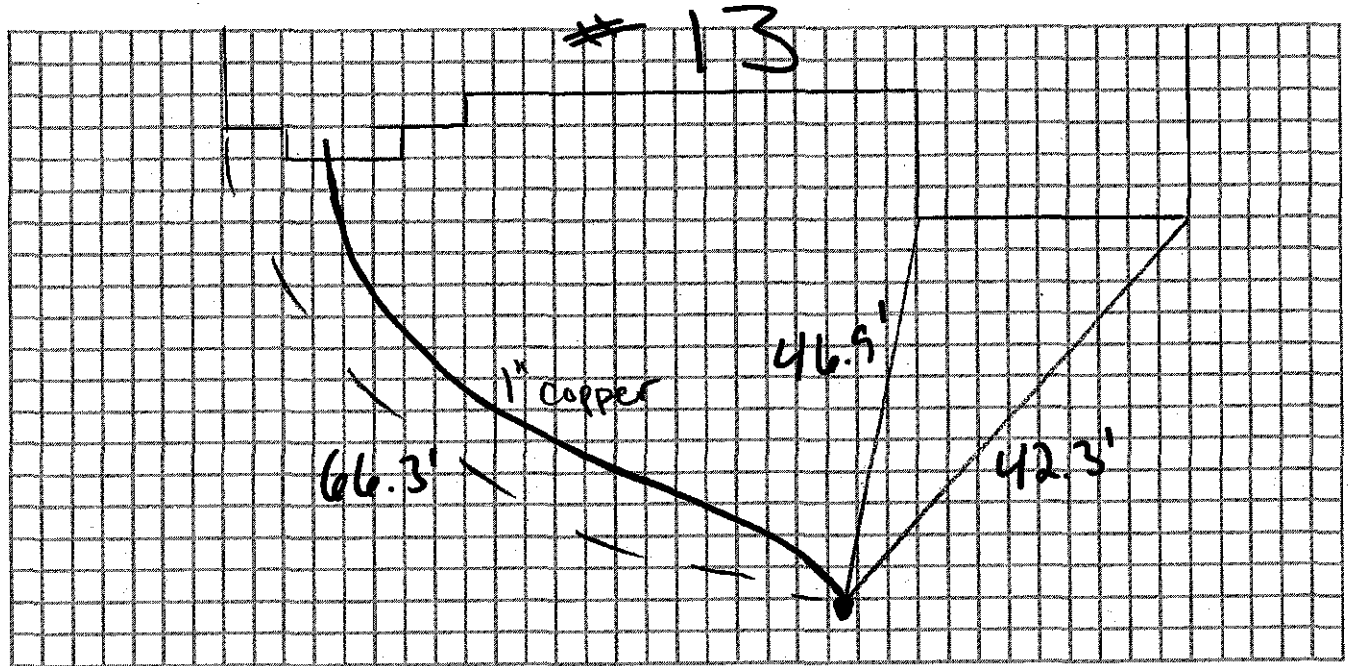

Connection made in: Appletree Ln Street. Work completed:

Remarks:

depth @ curb stop = 6'