

**WATER SERVICE RECORD**

Name \_\_\_\_\_

**Service No.**

Address #3 Apollo Circle (lot 5)

## Location

## **Repair—Renewal—New Service**


Defect #3025

DATE

**TOWN OF LEXINGTON — BOARD OF PUBLIC WORKS**

**WATER DIVISION**

### **Sketch of Service Here**

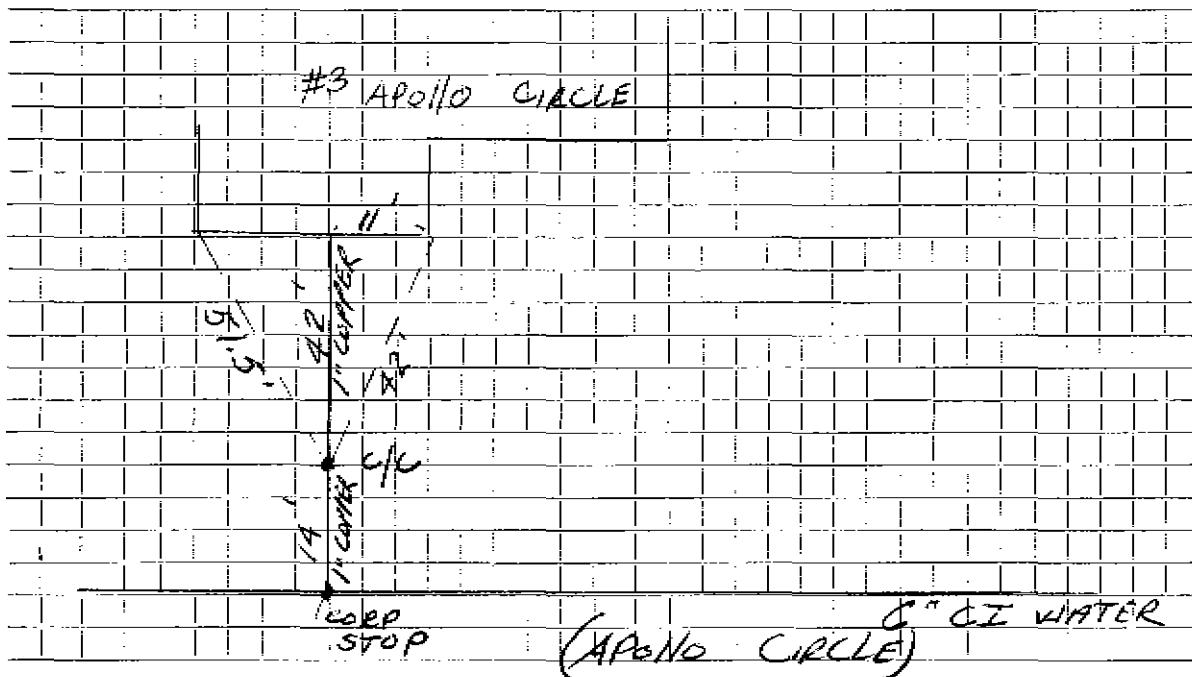

Connection made in . . . . . *Apollo Circle*, Street.

Work completed . . . . .

**Remarks:**