




TOWN OF LEXINGTON — BOARD OF PUBLIC WORKS

**WATER DIVISION**

Sketch of Service Here

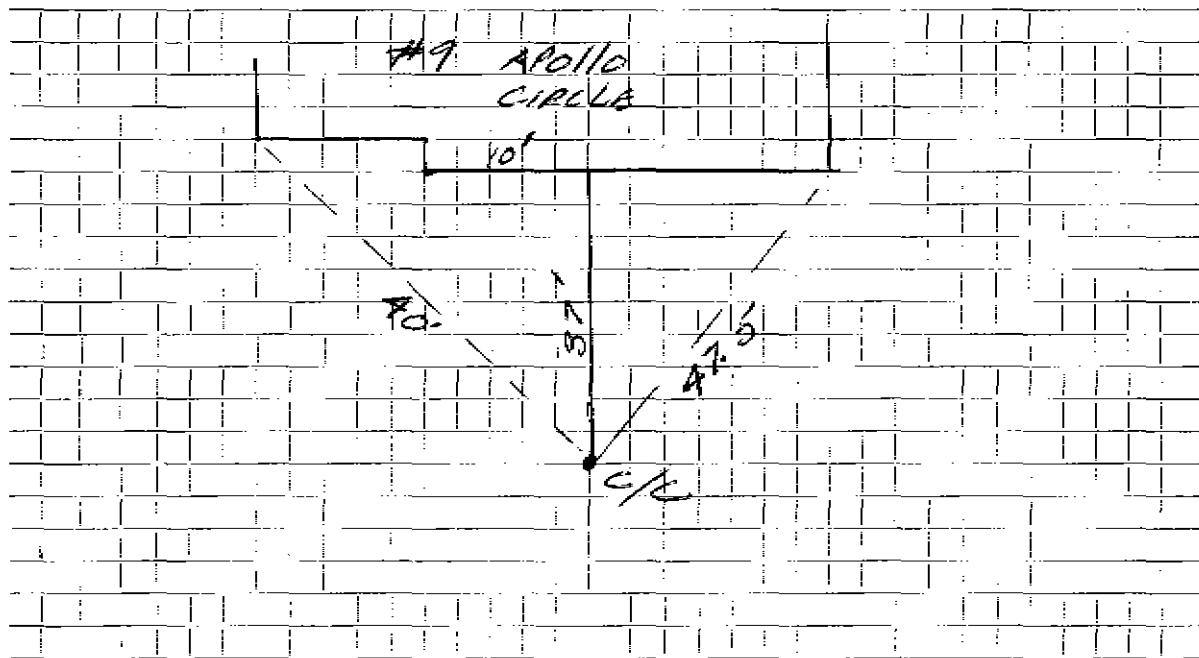

Connection made in APOLLO CIRCLE ..... ~~Street~~ Work completed .....

Remarks: .....

.....

.....