WATER SERVICE RECORD

Total

Date

Service No.

Amount

Address 15 to 17 April Lane

Amount

Location

Material

Name

Date


Repair—Renewal—New Service

_		_	
_	Α.	т	6
_	_		-

TOWN OF LEXINGTON - BOARD OF PUBLIC WORKS

WATER DIVISION

Sketch of Service Here

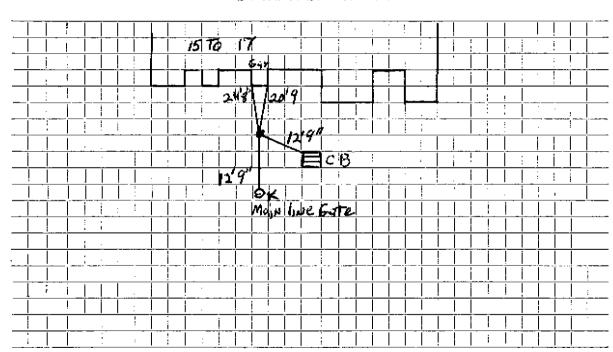

Connection made in Street.	Work completed
Remarks:	************************************