

## WATER SERVICE RECORD

Name A &amp; E Construction Co.

Service No. 241

Address 31 Arcola Street, Lexington

Location

~~Repair - Renewal~~ - New Service

Comm. 11-19-56


Date	Material	Amount	Total	Date	Amount	
8/20/56	Labor	1 90		8-15-56	Deposit	50 00
	10% Overhead	20	2 10	11-19-56	Refund	25 21
	35' 3/4" Copper tubing @.4850	16 98			<u>NON CHARGE</u>	24 79
	1-3/4" Cx 1/2 IWH stop & waste		4 96	8/20/56	Labor	1 90
	1 hr. trucking @.75		75	37' 3/4" Copper tubing @.4850		17 95
			24 79	1-3/4" C Corp Cock		4 64
				1-3/4" C Curb Cock		5 94
				1 Box & Rod		4 62
				1-1/2" straight tail piece		50
				1-1/2" offset tail piece		50
						36 05

DATE

TOWN OF LEXINGTON — BOARD OF PUBLIC WORKS

**WATER DIVISION**

Sketch of Service Here

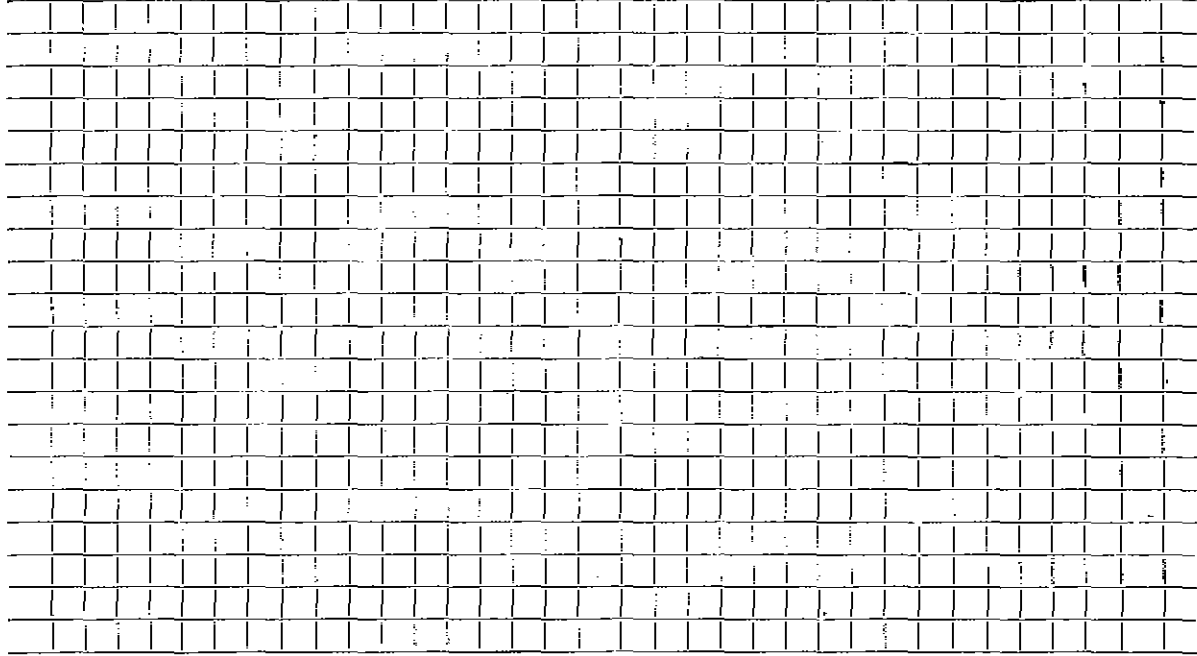

Work completed

Street

Connection made in

Remarks: